


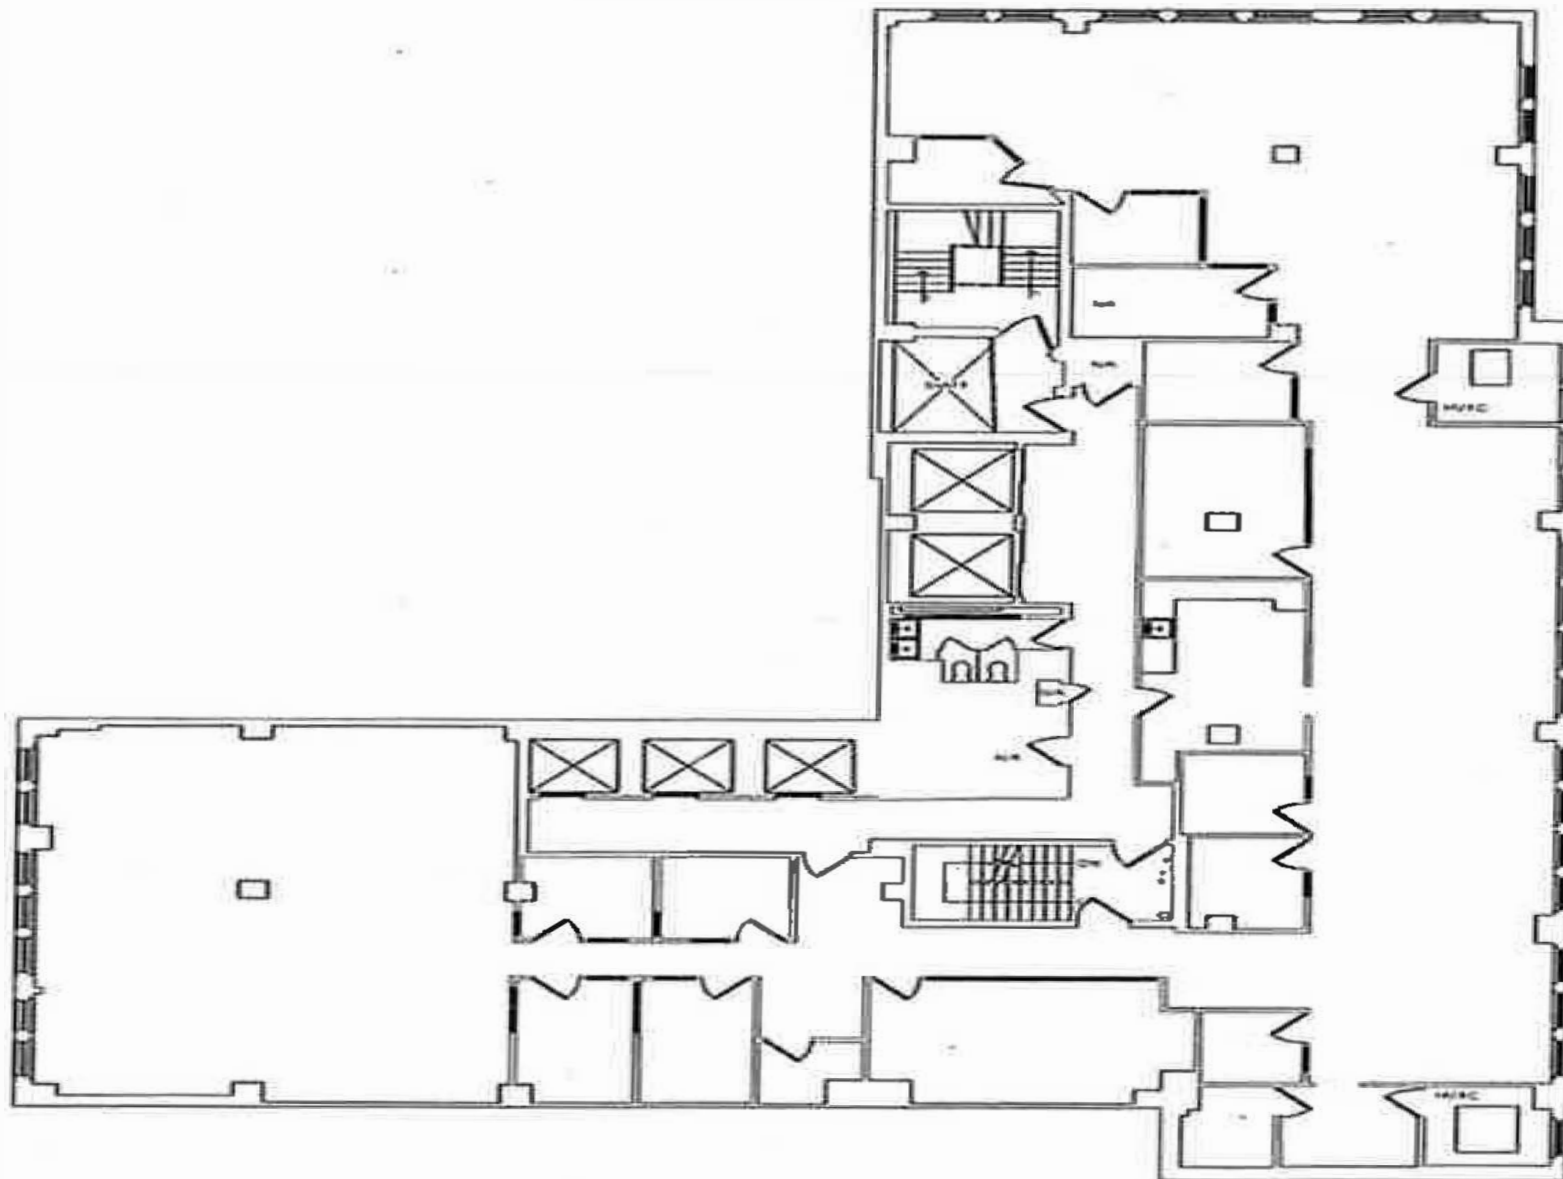

①9 NINETEENTH FLOOR PLAN
 $\frac{1}{16}" = 1'-0"$

As Built

307 7th Ave
New York, NY
10001

FL19

190425
DATE 11.20.2018