



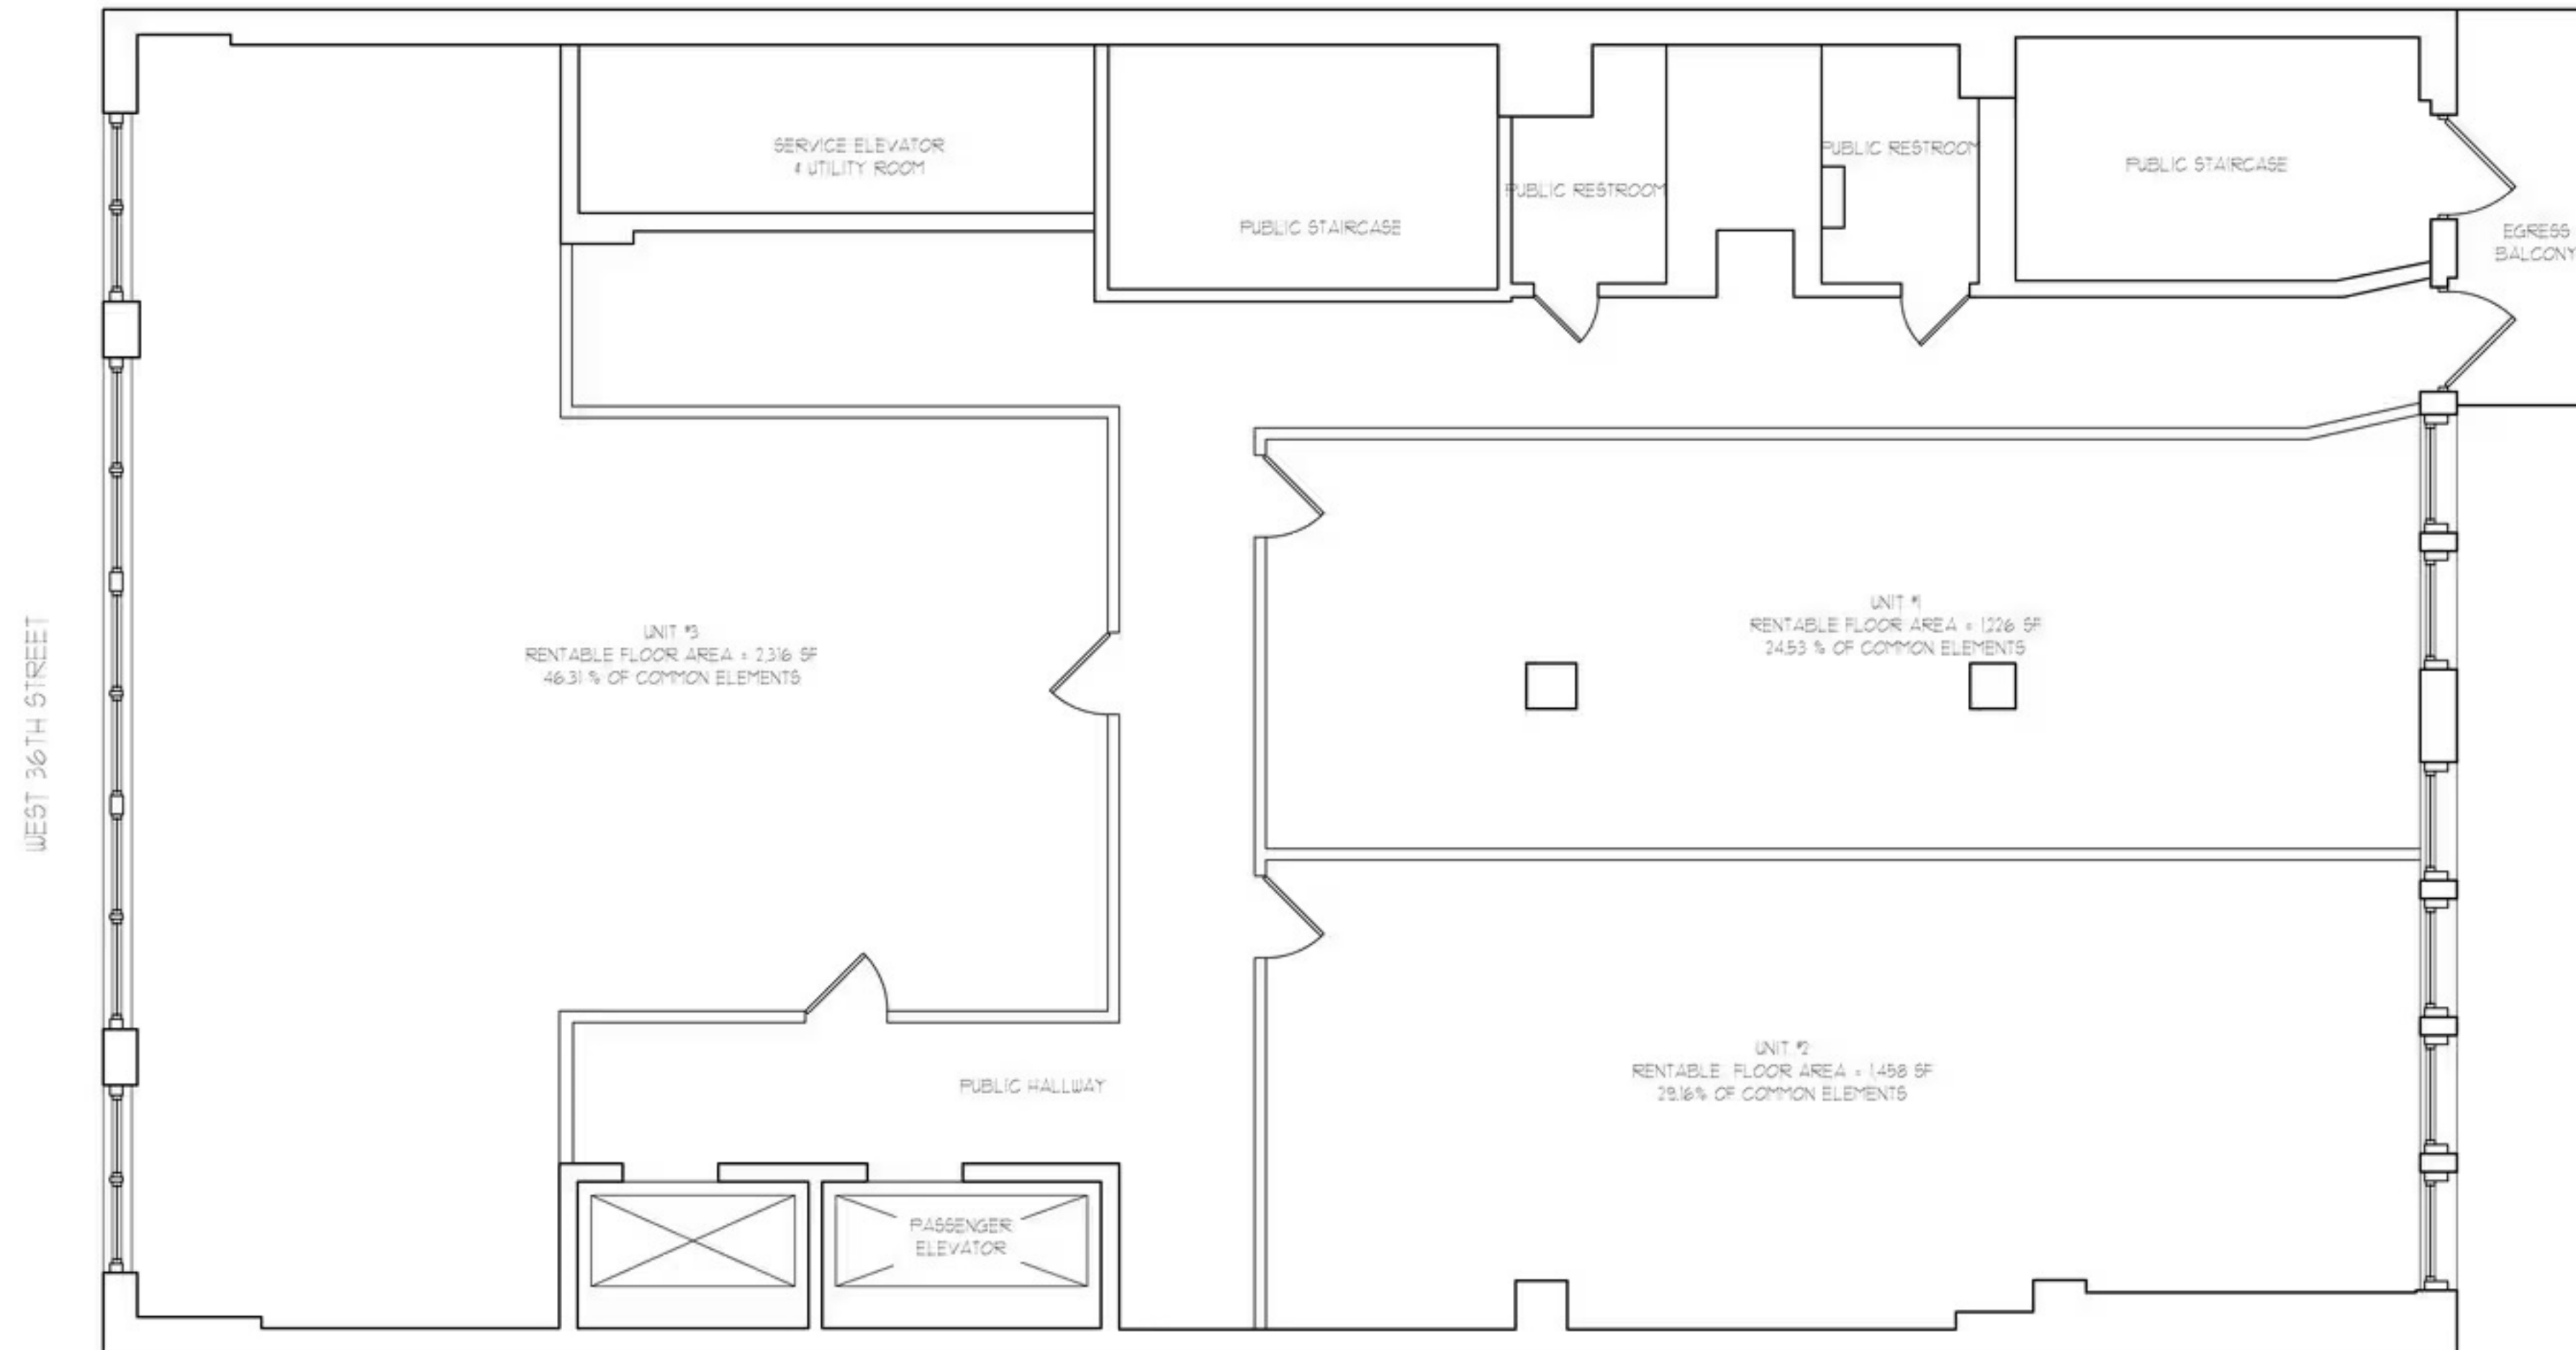

1 AS BUILT PLAN | 5TH FL
SCALE: 1/4" = 1'-0"

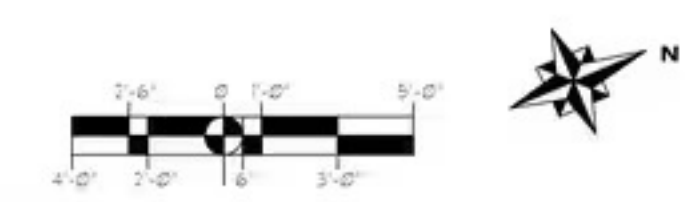

NO.	REVISION	DATE

The Contractor shall check and verify all dimensions on site and report any discrepancies in writing to Bohen Architect, before proceeding with work. All drawings are the property of Bohen Architect, and shall not be reproduced without the written consent of Bohen Architect. Drawings shall not be scaled for information. All Rights Reserved. This plan is approved only for work indicated on the application specification sheet. All other matters shown are not to be relied upon or to be considered as either being approved or in accordance with applicable codes.

PROJECT
AREA CALCULATION
15 W 36TH STREET
NEW YORK, NY

AS BUILT
5TH FLOOR

SEAL & SIGNATURE	DATE: 12-28-2024
	SCALE: AS NOTED
	PRO. No.: 24-AR-018
	DRAWING BY: BC
	CHECKED BY: BC
DWG No.	
5 TH FL	
DWG PAGE: 1 OF 1	