


KEY PLAN

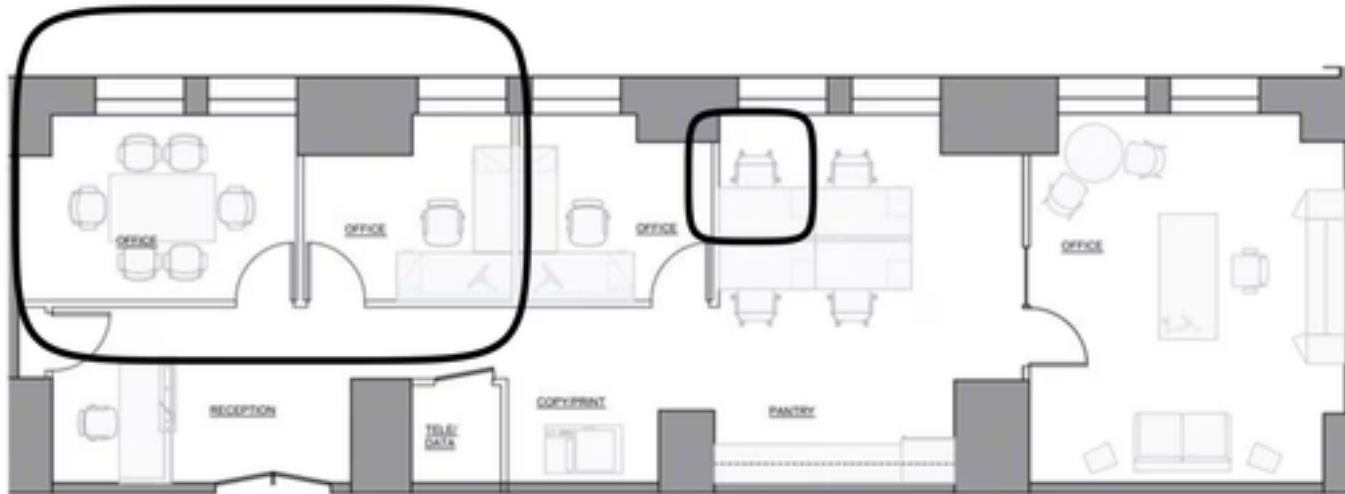

FLOOR PLAN

SCALE: 1/8" = 1'-0"

SUITE 922
AS-BUILT

9TH FLOOR
230 PARK AVENUE
NEW YORK, NEW YORK