




SPACE TYPE	QTY
OFFICES	2
BF CONFERENCE ROOM	1
WORKSTATIONS	2
RECEPTION	1
PANTRY	1
LT. ROOM	1

— ALL DIMENSIONS AND CONDITIONS ARE —
APPROXIMATE AND SUBJECT TO FIELD VERIFICATION

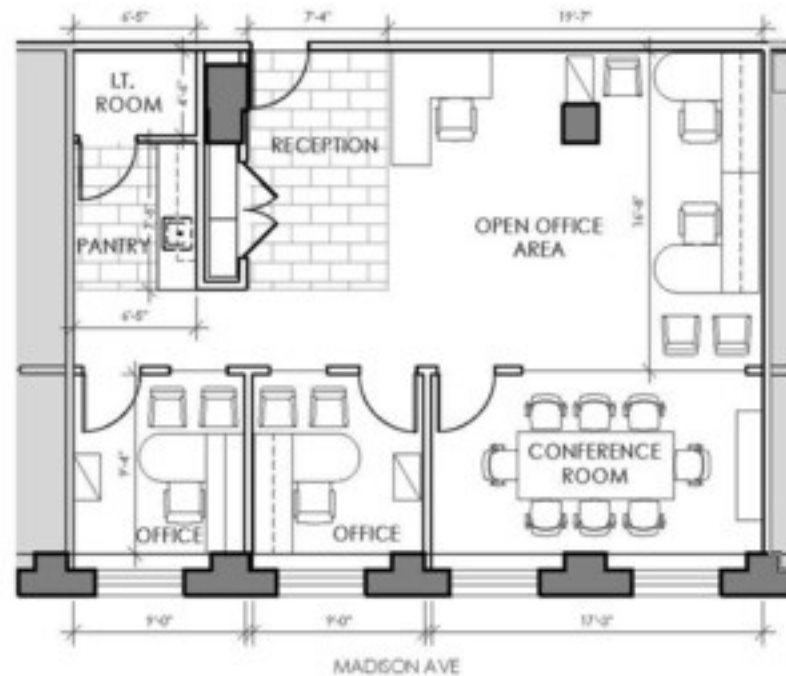

11TH FLOOR SUITE 11C AS BUILT DATE: 11.4.2021 DWG. NO.: SS&01	DS 400 400 MADISON AVE NEW YORK, NY	
---	---	--