TOWER56

@ PARK AVENUE


Partial 2nd Floor

Suite 200 - As-Built Plan

1,889 RSF

Highlights

- Currently built, move-in ready
- Landlord can modify
- Recent building renovation featuring a new lobby and multi-level amenity center
- 2 Private Offices
- 5 Shared Offices
- 1 Conference Room
- 1 Reception
- 1 Pantry
- ⊥ 1.1
- 8 Total Headcount

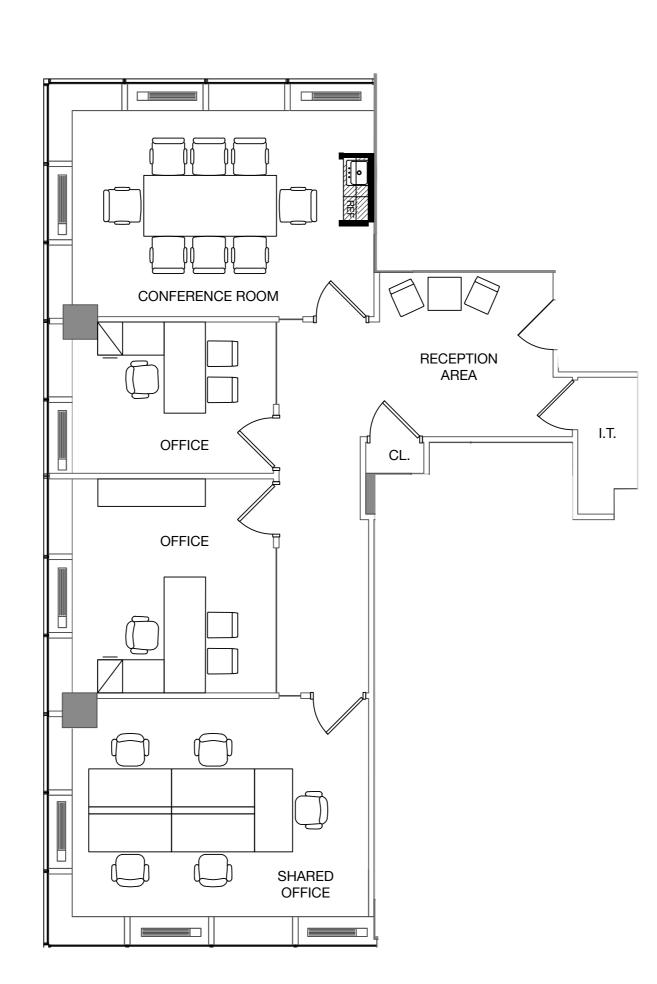

EAST 55TH STREET





