

ENTIRE 25TH FLOOR – 10,250 RSF

AS-BUILT PLAN



WEST 39th STREET

SEVENTH AVENUE




ENTIRE 25TH FLOOR – 10,250 RSF

TEST FIT: OFFICE INTENSIVE OPTION A



WEST 39th STREET

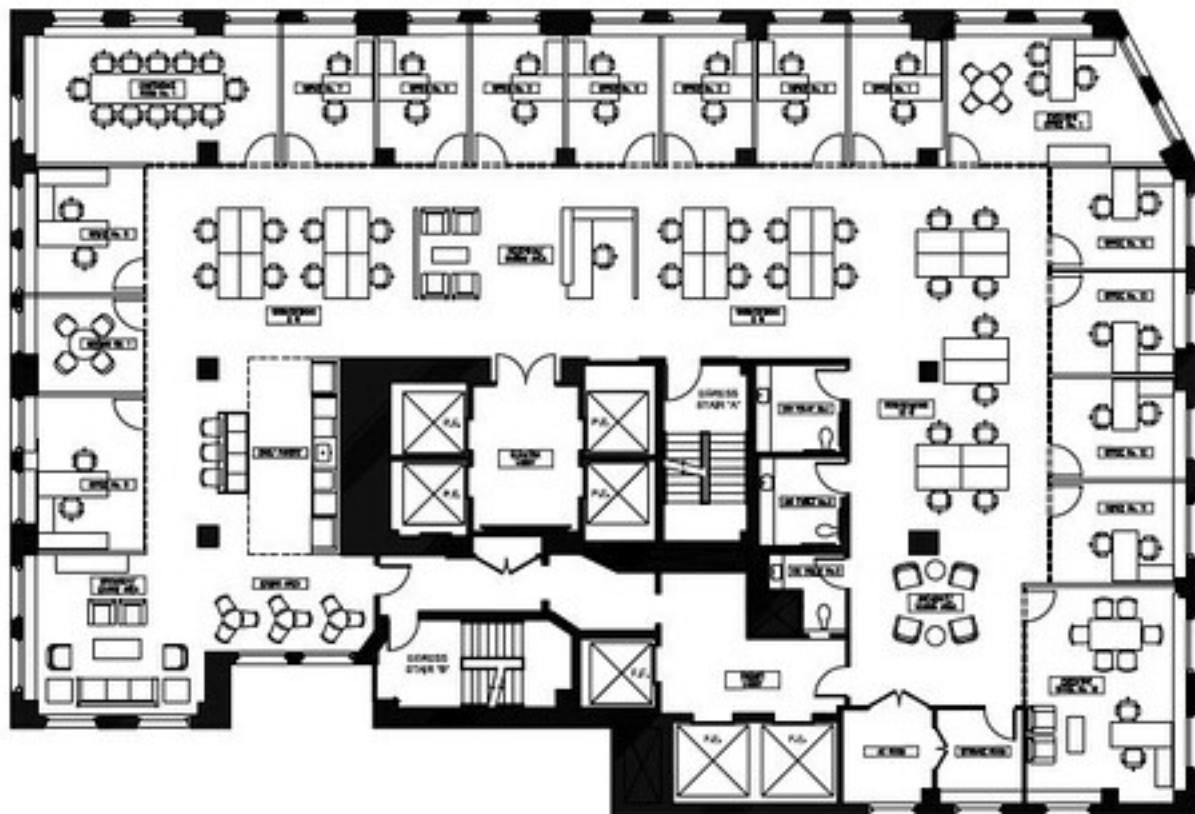

SEVENTH AVENUE


RECEPTION AREA	1	CONFERENCE ROOM	1	BREAKOUT/LOUNGE	2
EXECUTIVE OFFICES	2	MEETING ROOM	1	PANTRY/BAR	1
OFFICES	13	OPEN WORKSTATIONS	26	EATING AREA	1

ENTIRE 25TH FLOOR – 10,250 RSF

TEST FIT: OFFICE INTENSIVE OPTION B



WEST 30th STREET

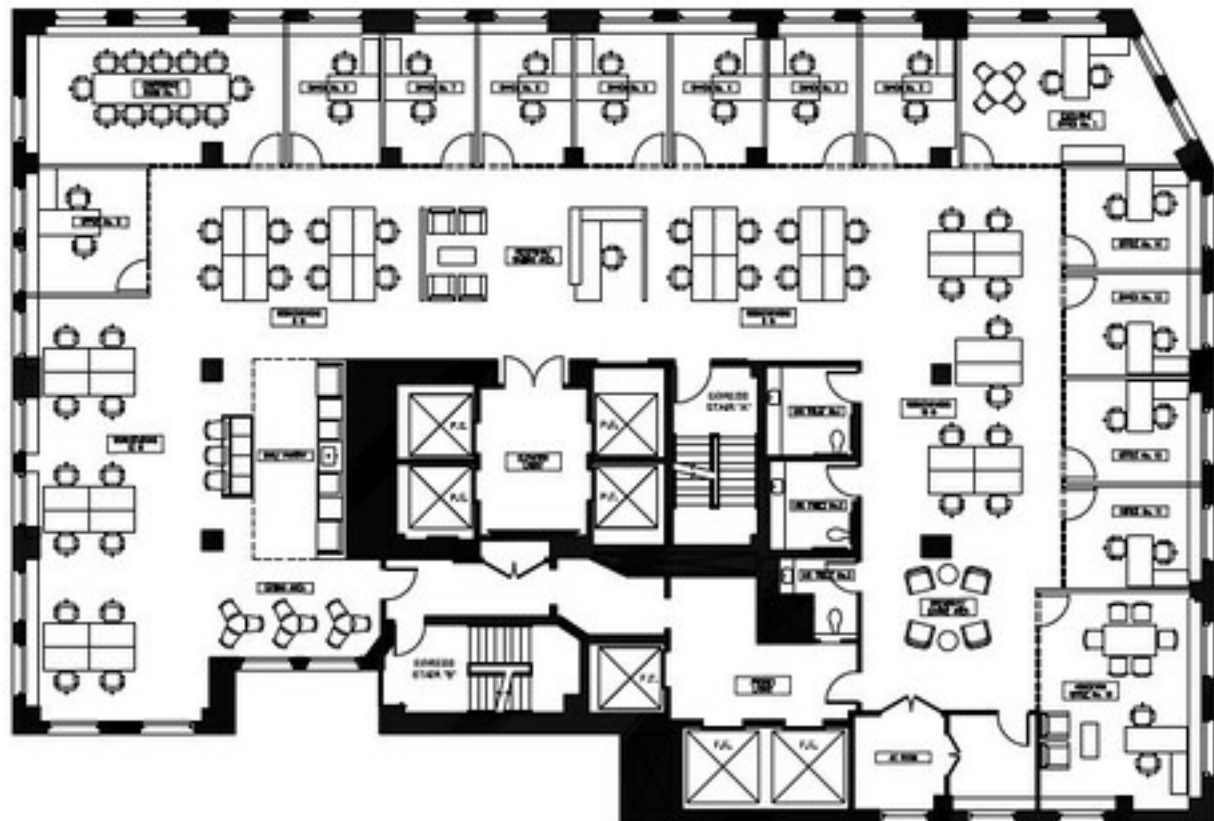

SEVENTH AVENUE


RECEPTION AREA	1	CONFERENCE ROOM	1	PANTRY/BAR	1
EXECUTIVE OFFICES	2	OPEN WORKSTATIONS	38	EATING AREA	1
OFFICES	12	BREAKOUT/LOUNGE	1		

ENTIRE 25TH FLOOR – 10,250 RSF

TEST FIT: OPEN PLAN



WEST 39th STREET

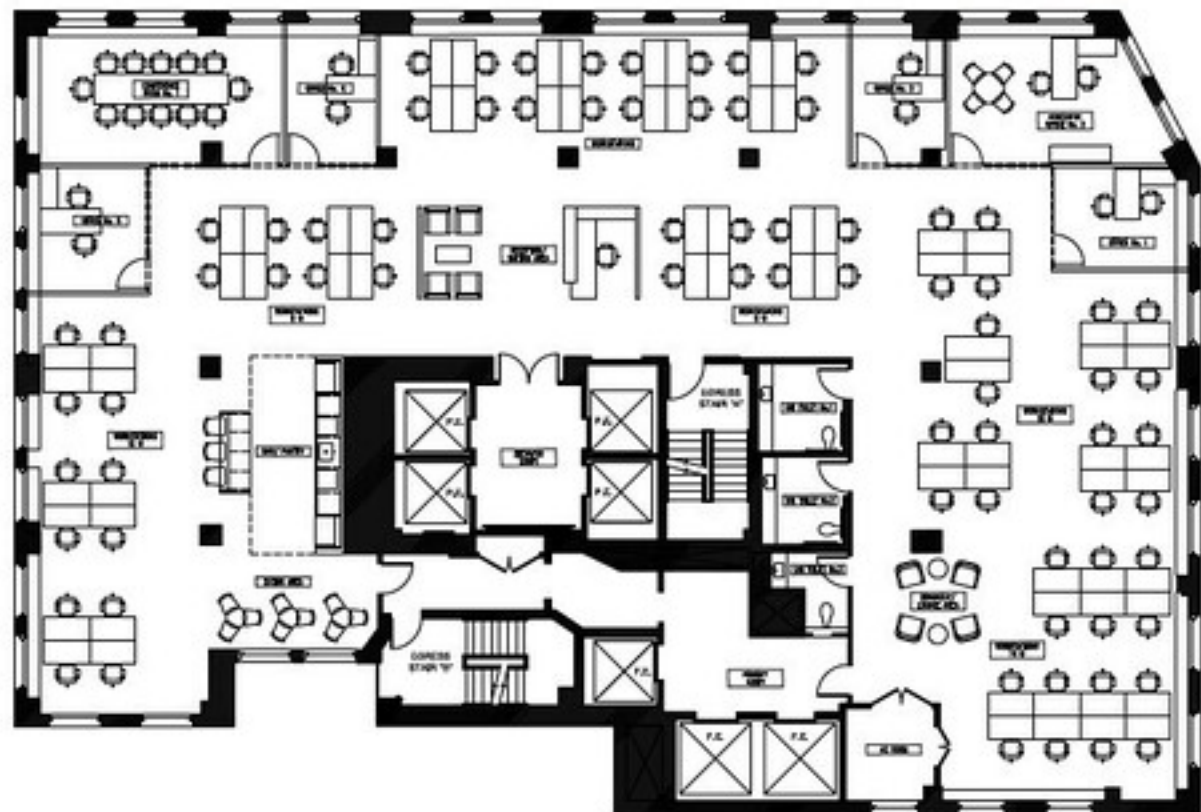

SEVENTH AVENUE

RECEPTION AREA	1	CONFERENCE ROOM	1	PANTRY/BAR	1
EXECUTIVE OFFICES	1	OPEN WORKSTATIONS	60	EATING AREA	1
OFFICES	4	BREAKOUT/LOUNGE	1		