


As Built Plan, 9th Floor

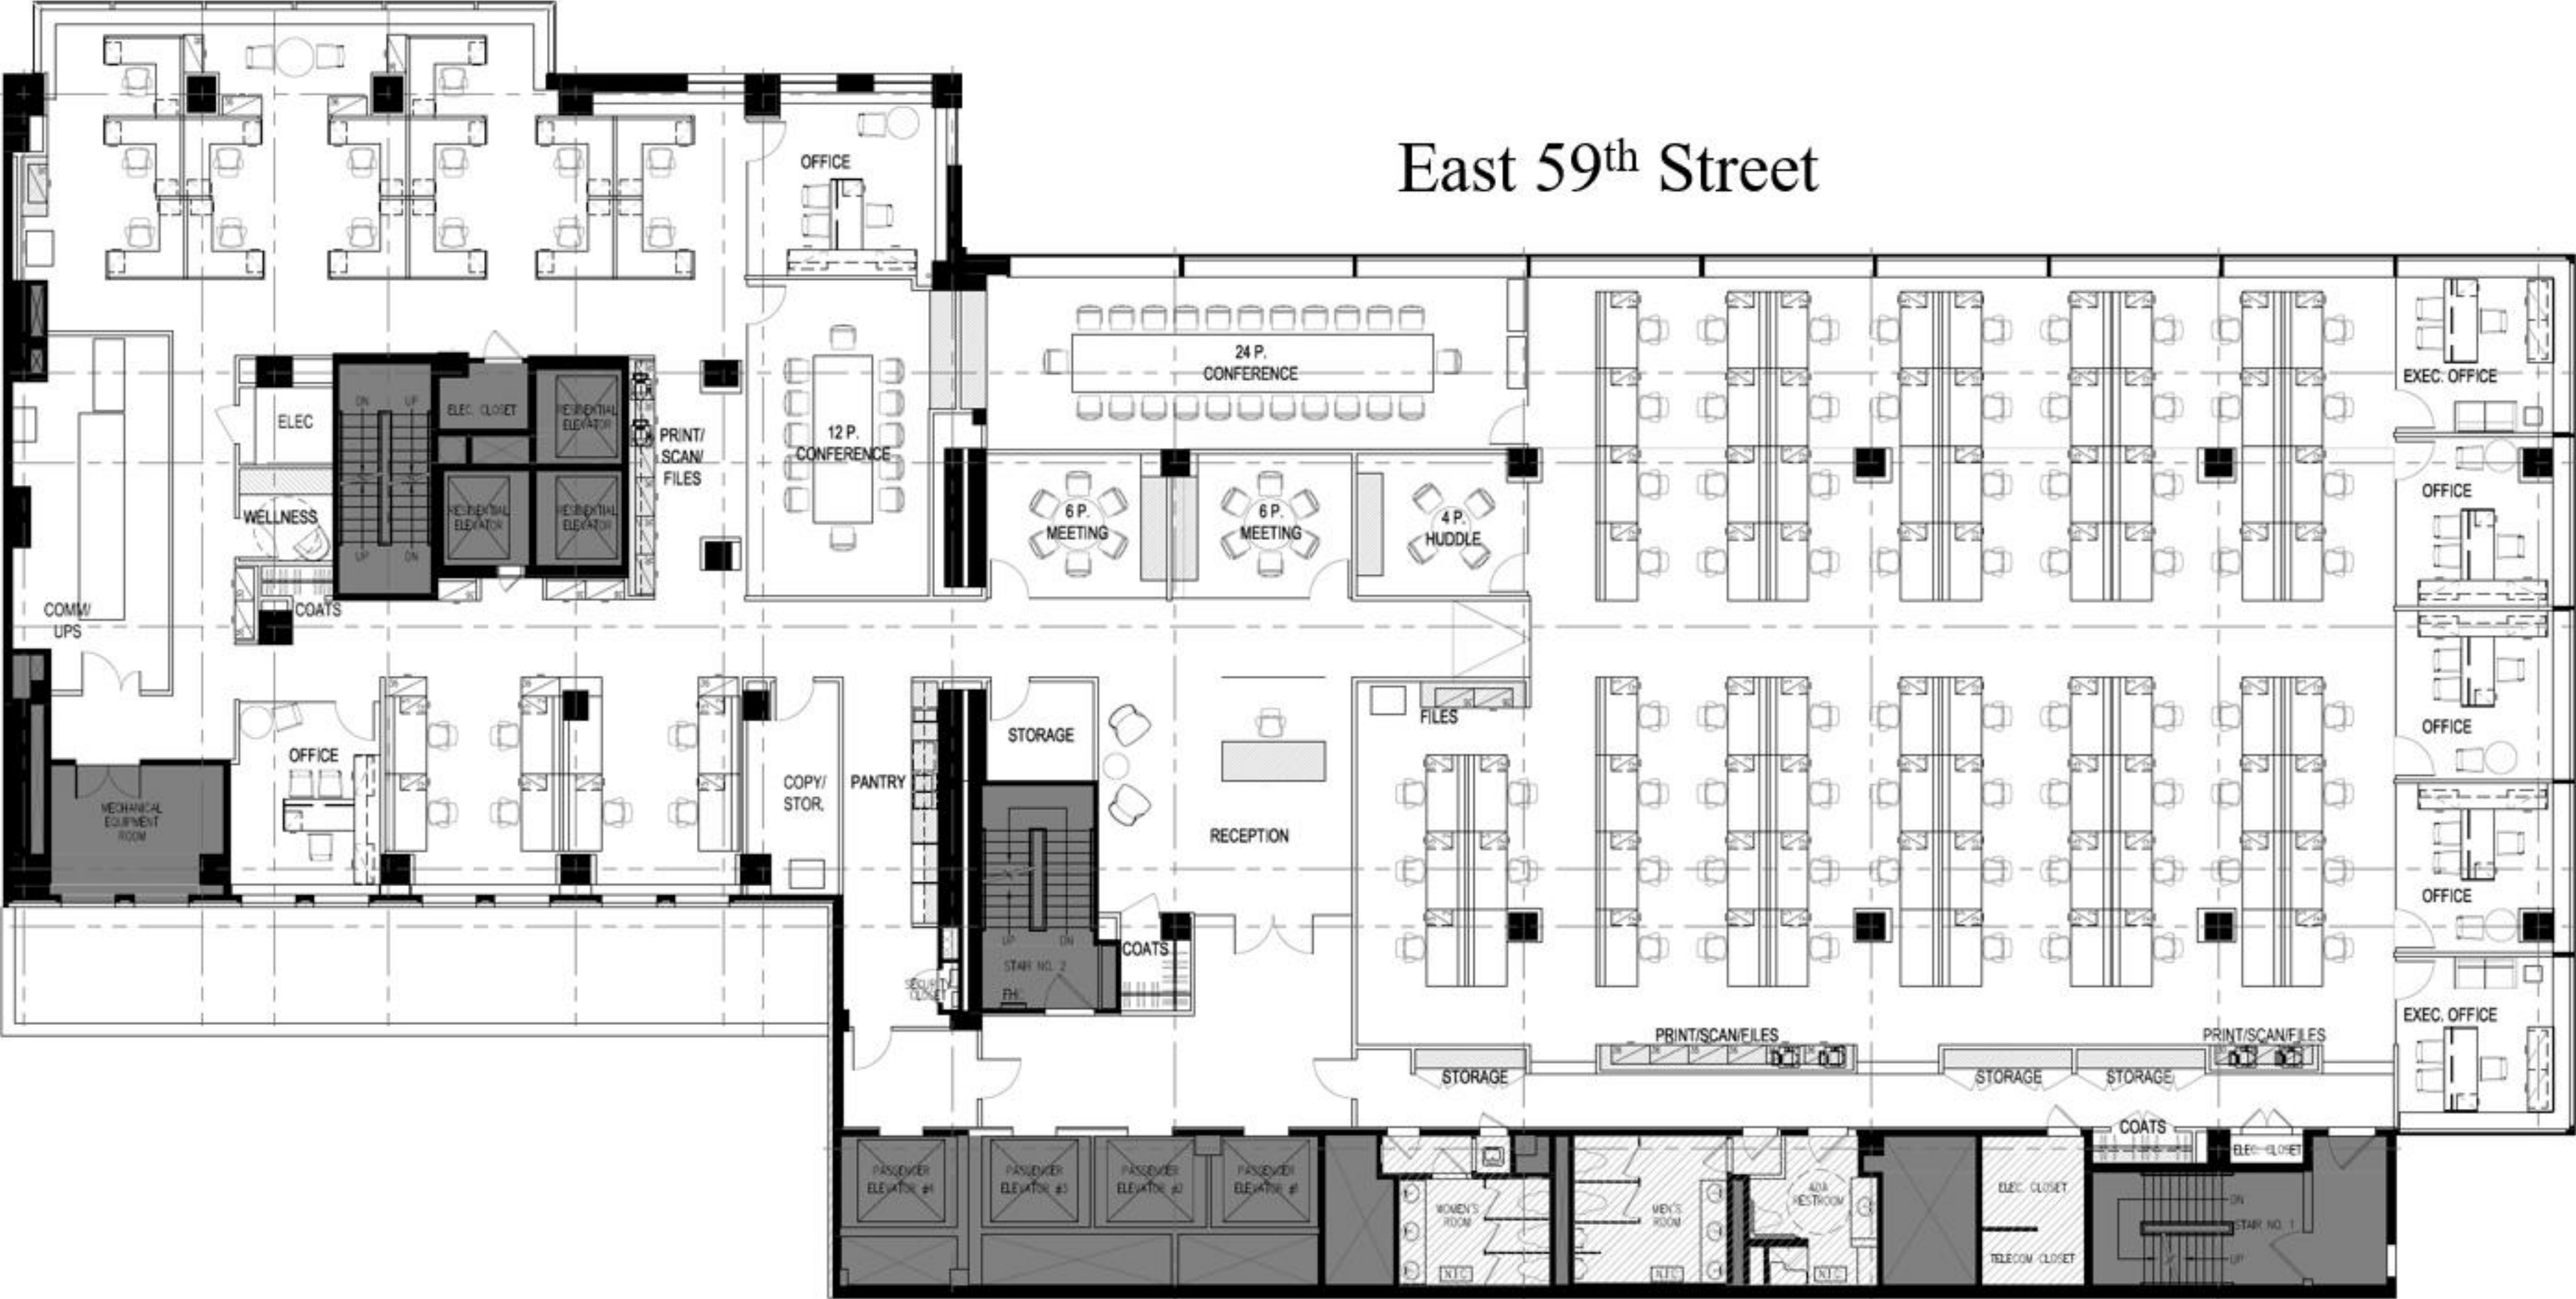

East 59th Street

Park Avenue