


1 AS BUILT PLAN : 5TH FL  
SCALE: 1/4"=1'-0"

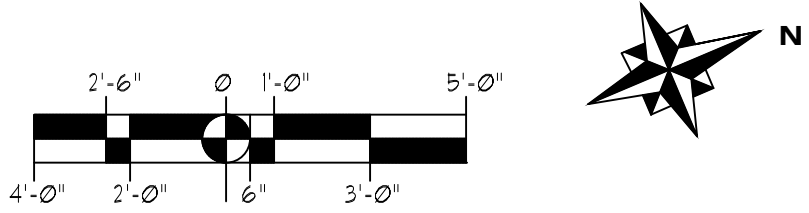

B Chen Architect PLLc,  
52-21 Van Dam Street, L.I.C., NY 11101  
473 Main Street, Catskill, NY 12414

tel: 718.440.8741

NO.	REVISION	DATE

The Contractor shall check and verify all dimensions on site and report any discrepancies in writing to Bchen Architect, before proceeding with work. All drawings are the property of Bchen Architect, and shall not be reproduced without the written consent of Bchen Architect. Drawings shall not be scaled for information. All Rights Reserved. This plan is approved only for work indicated on the application specification sheet; all other matters shown are not to be relied upon or to be considered as either being approved or in accordance with applicable codes.

PROJECT  
AREA CALCULATION  
15 W 36TH STREET  
NEW YORK, NY

AS BUILT  
5TH FLOOR

SEAL & SIGNATURE	DATE: 12-28-2024
	SCALE: AS NOTED
	PRO. No.: 24-AR-018
	DRAWING BY: BC
	CHECKED BY: BC
DWG No.:	
5 TH FL	
DWG PAGE:	
PAGE 1 OF 1	