


KEY PLAN

42 RD STREET

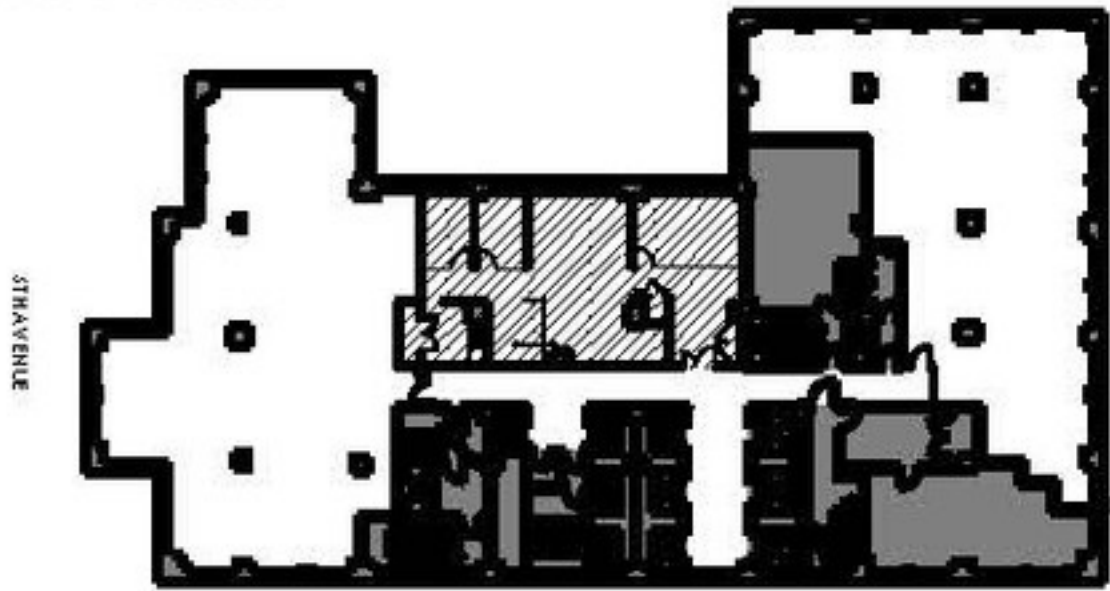

| SPACE SUMMARY | | | |
|------------------|----|-----------|---|
| OFFICES | 4 | COPY | 1 |
| WORKSTATIONS | 14 | PANTRY | 1 |
| TOTAL HEAD COUNT | 18 | CLOSET | 1 |
| | | IT | 1 |
| | | RECEPTION | 1 |



500 FIFTH AVENUE
SUITE 2320



AS-BUILT PLAN

DWG: SSK-500-2320

NOT TO SCALE

| SPACE SUMMARY | |
|------------------|----|
| OFFICES | 1 |
| BENCHING | 17 |
| RECEPTION | 1 |
| TOTAL HEAD COUNT | 19 |
| CONFERENCE ROOM | 1 |
| PANTRY | 1 |
| IT | 1 |
| MECH. ROOM | 1 |

KEY PLAN

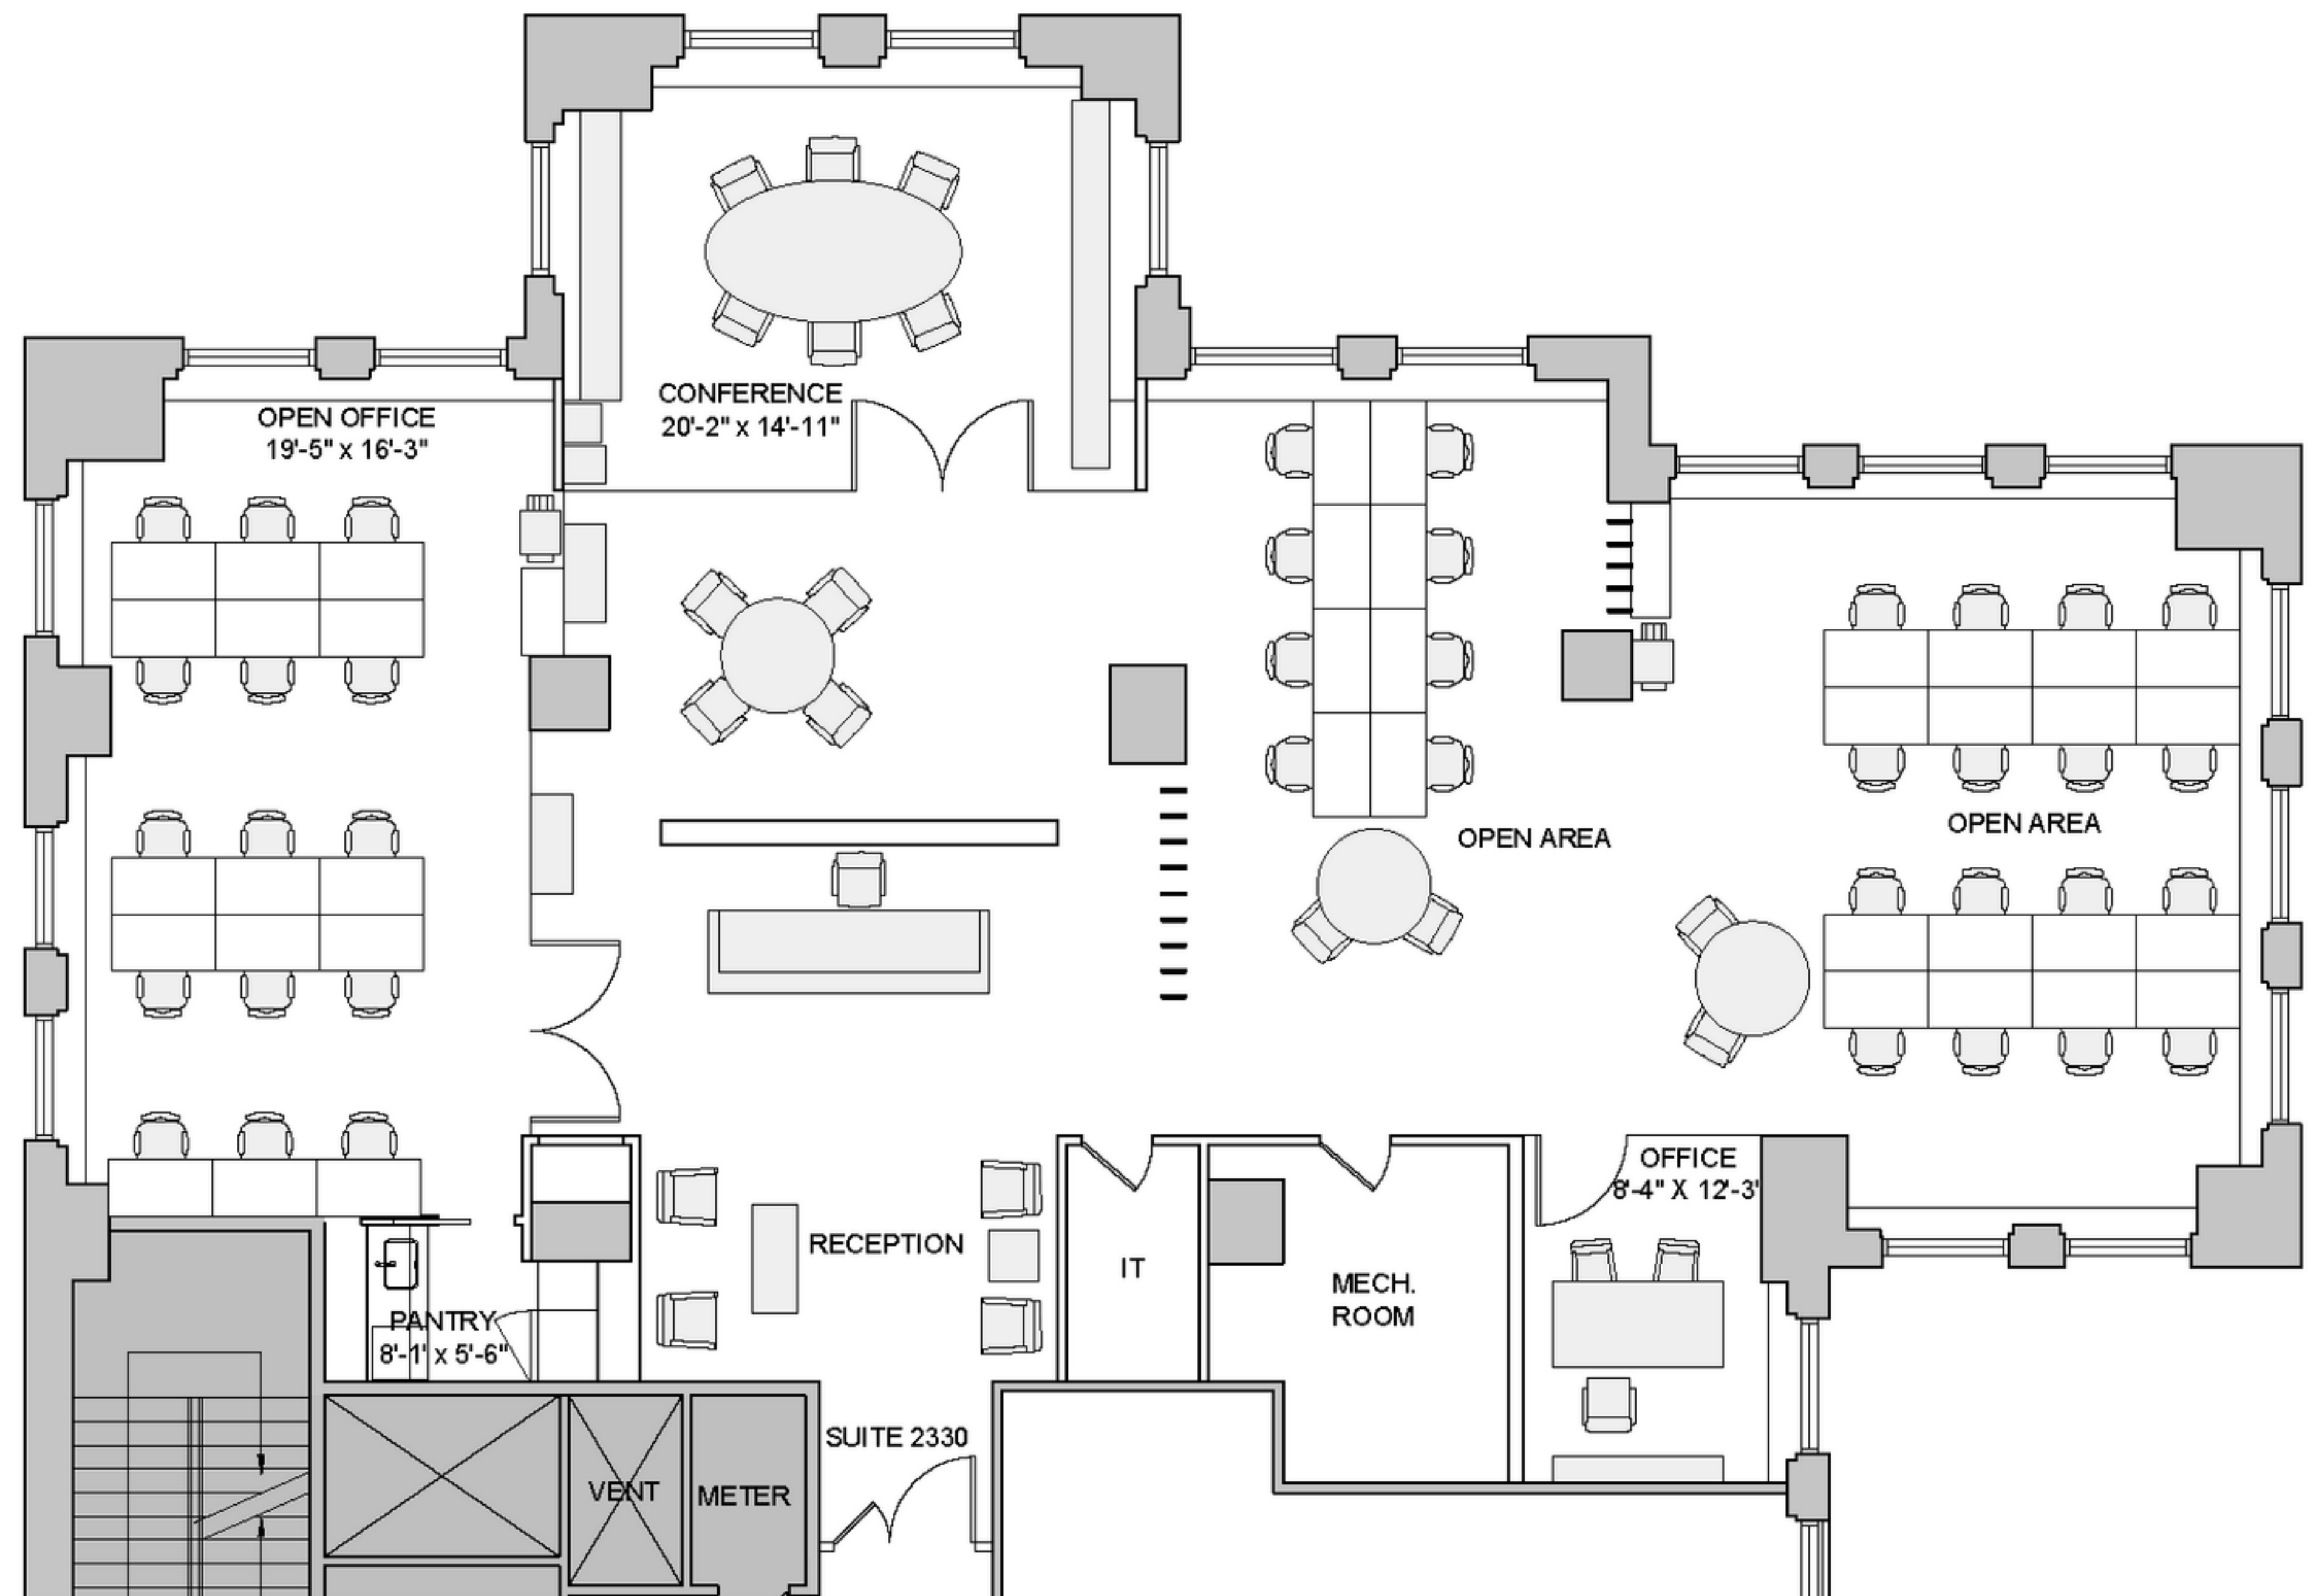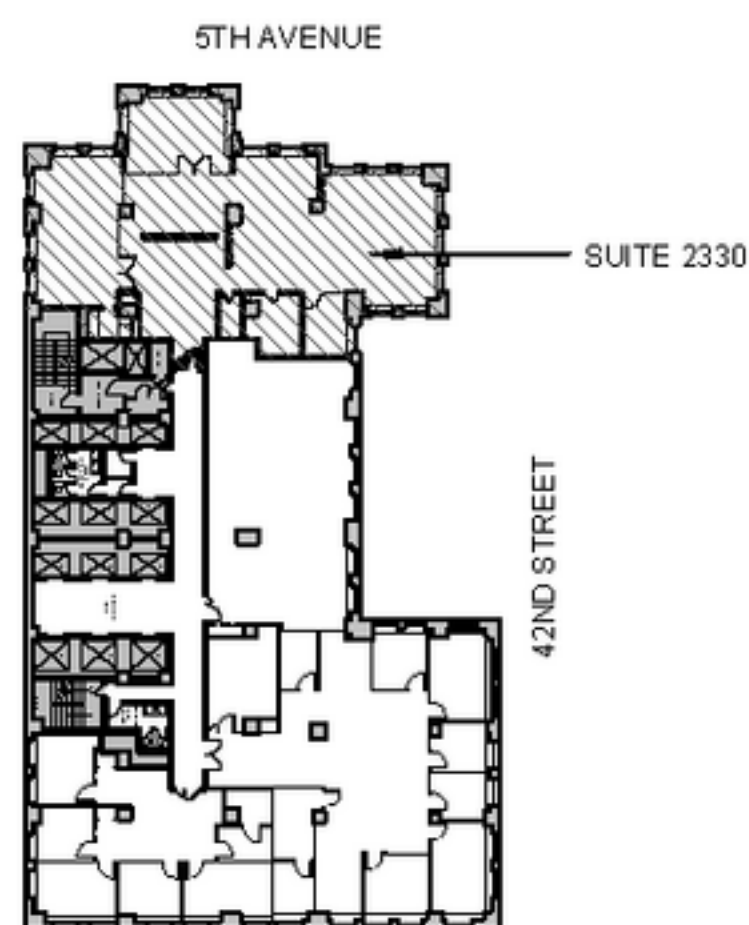

500 FIFTH AVENUE

SUITE 2330

5057 RSF

SPACE PLAN
SUITE 2330

DWG: IP-23

NOT TO SCALE