


West 49th Street

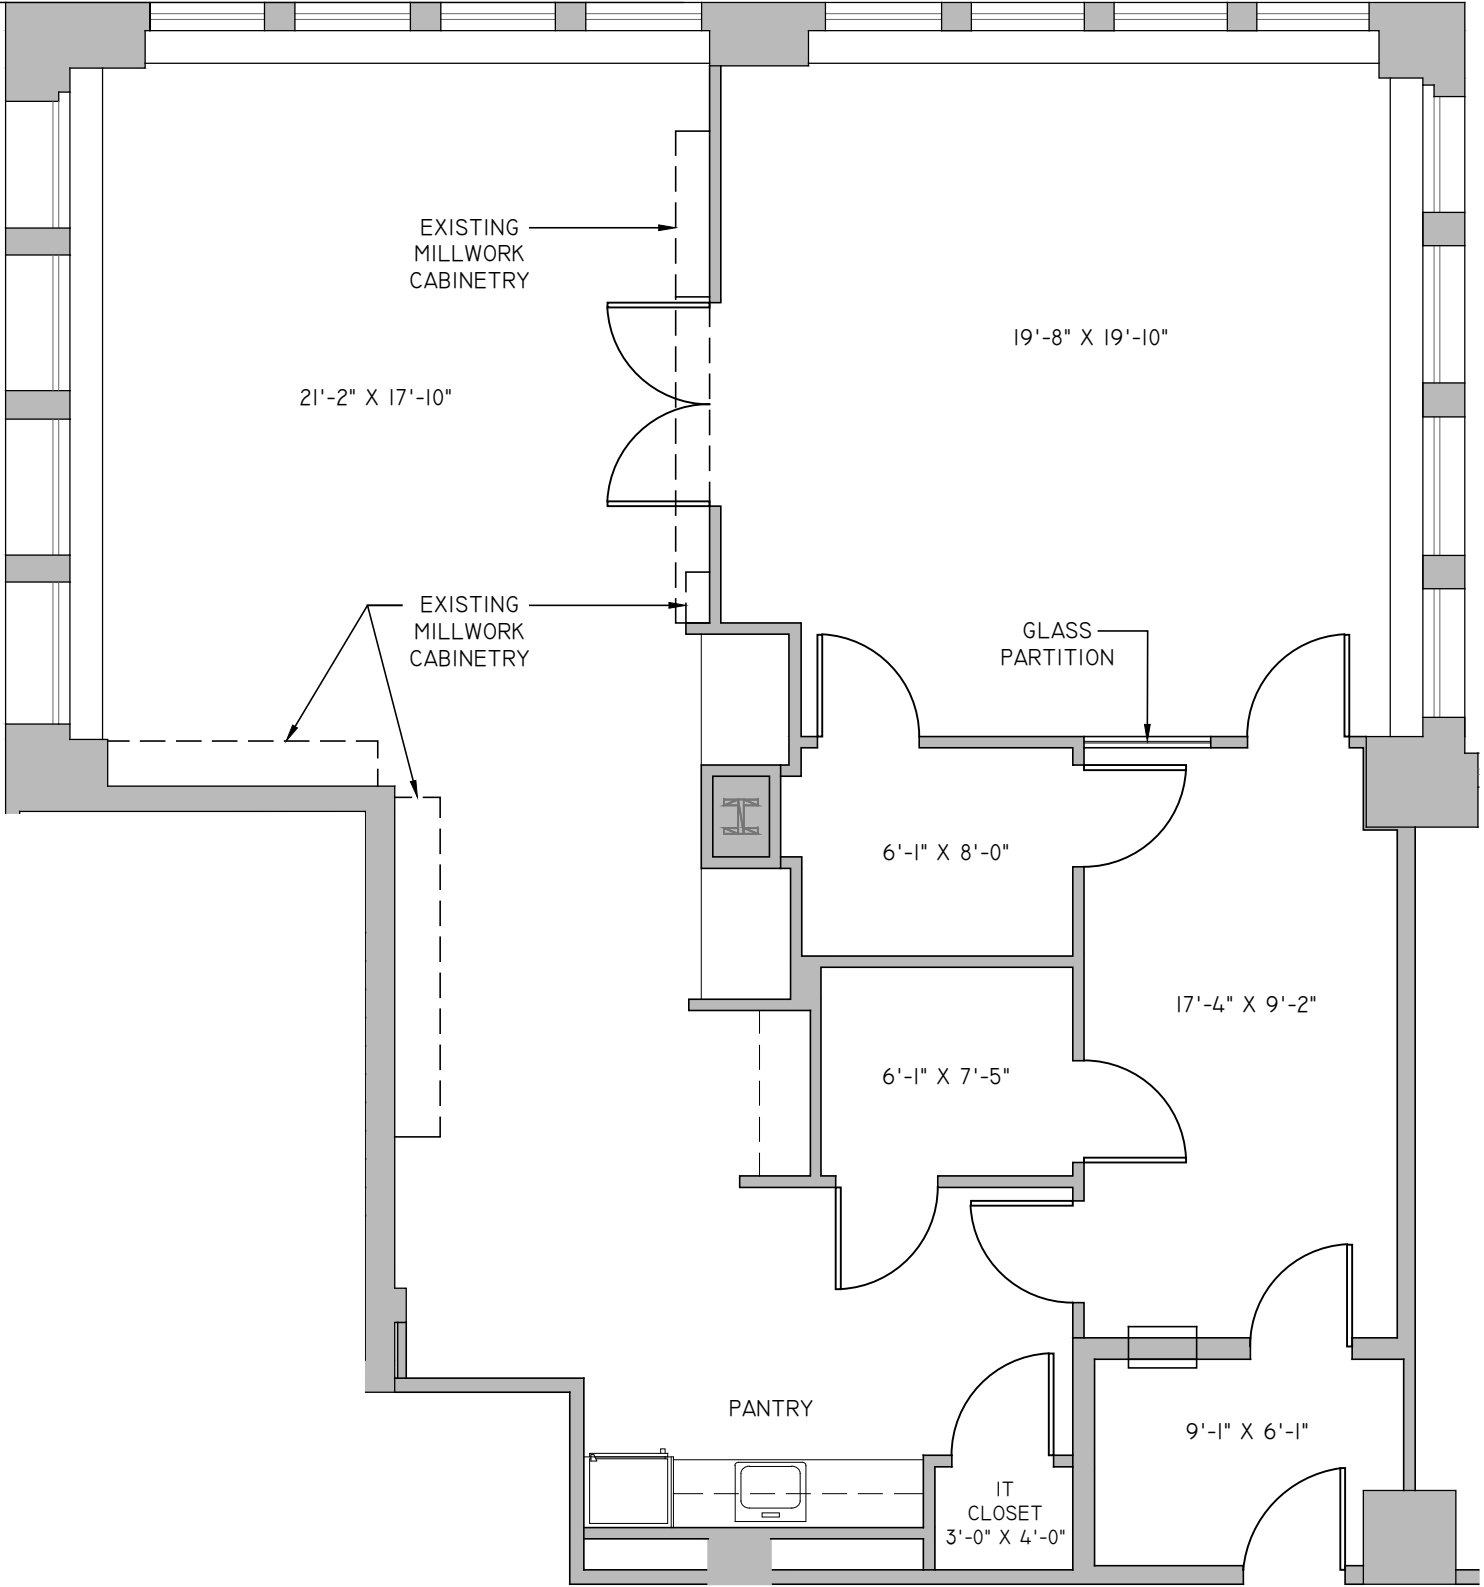

AS-BUILT FLOOR PLAN: AS-1

SCALE: NTS
SEPTEMBER 2, 2025

SUITE #507
608 5TH AVENUE
NEW YORK, NY