TOWER56

@ PARK AVENUE


Partial 5th Floor


As-Built Plan

2,889 RSF

Highlights

- Currently built, move-in ready
- Recent building renovation featuring a new lobby and multi-level amenity center
- Private Offices
- Open Area
- Conference Room
- 1 I.T.

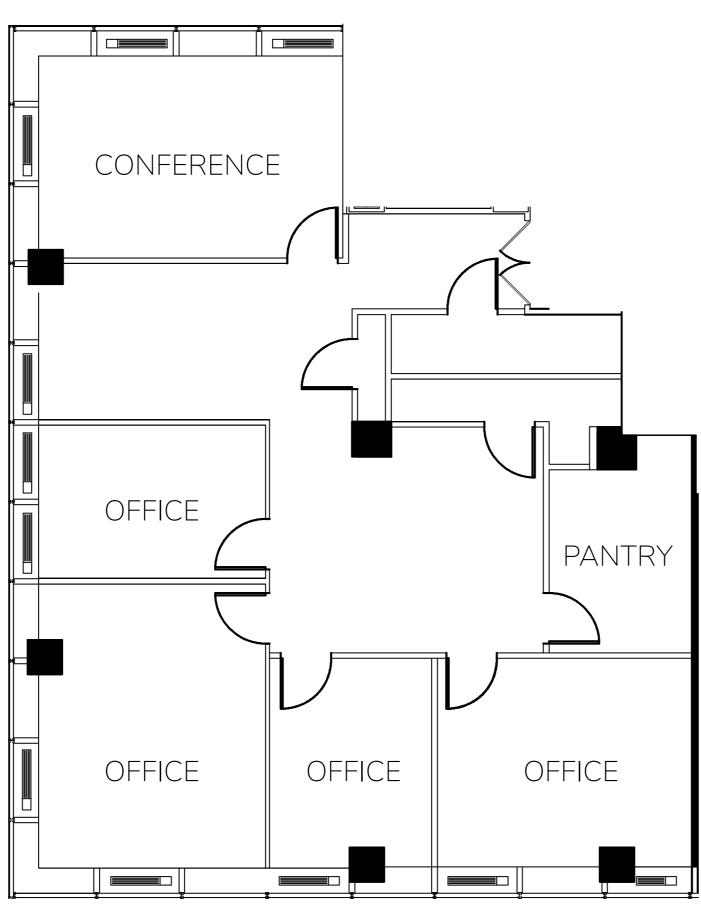

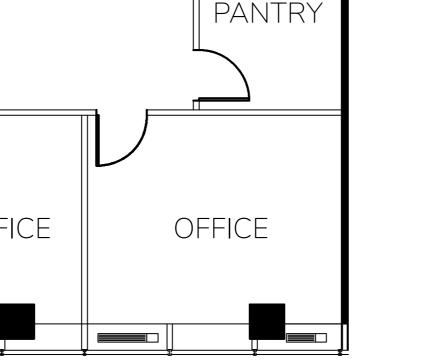







EAST 55TH STREET