

35 *west* 35

BETWEEN FIFTH AND SIXTH AVENUES


PARTIAL 12TH FLOOR
3,000 SF




35 *west* 35

BETWEEN FIFTH AND SIXTH AVENUES

Suite 1202

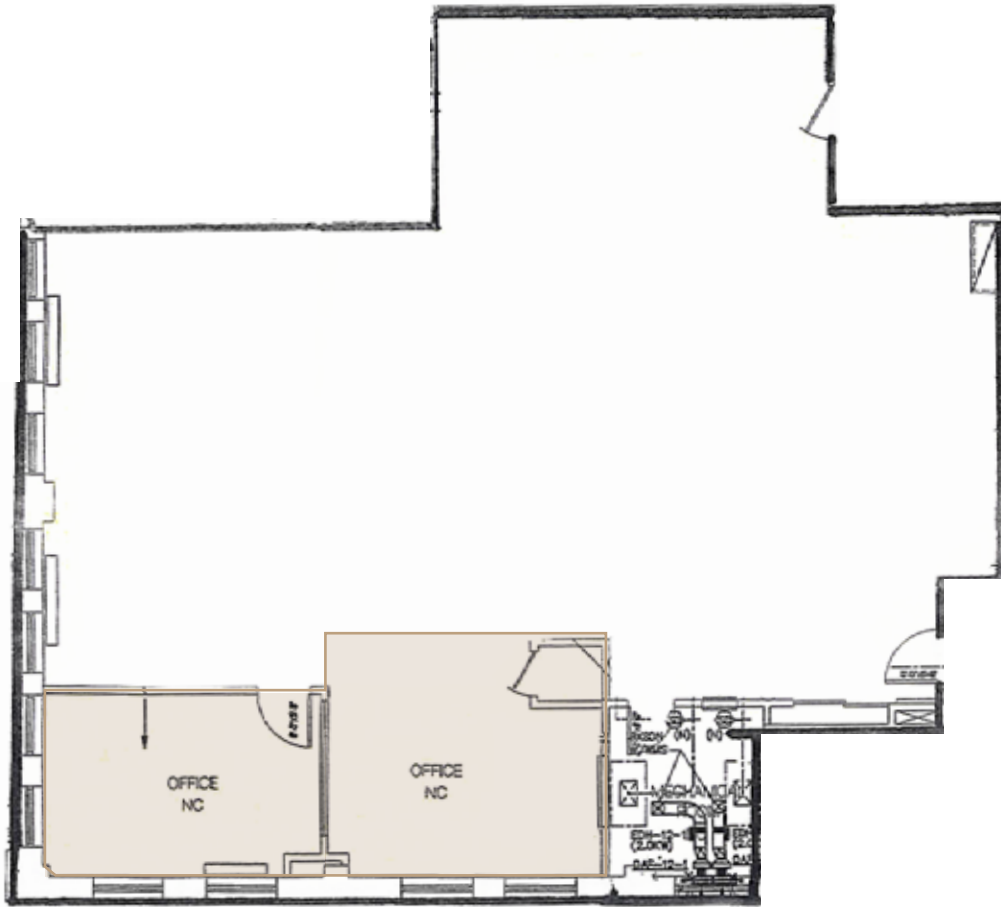

As-Built

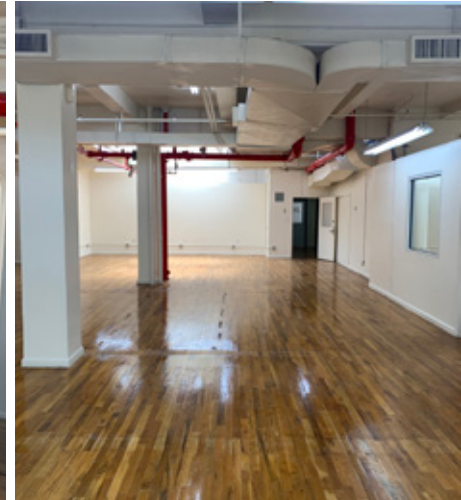

OFFICE /
SHOWROOM

SIZE 3,000 SF
CEILING HEIGHTS 12 FT

- EXCELLENT LIGHT
- 2 SKY LIGHTS
- TENANT CONTROLLED HVAC

- HARD WOOD FLOORS
- OPEN SPACE WITH 2 OFFICES
- ALL USES CONSIDERED

35 *west* 35

BETWEEN FIFTH AND SIXTH AVENUES

Neighborhood

