
641 Lexington Avenue

Floor 21 As Built Plan

3,295 Sq. Ft. Partial Floor Available March 1, 2025

Asking: \$65 per RSF

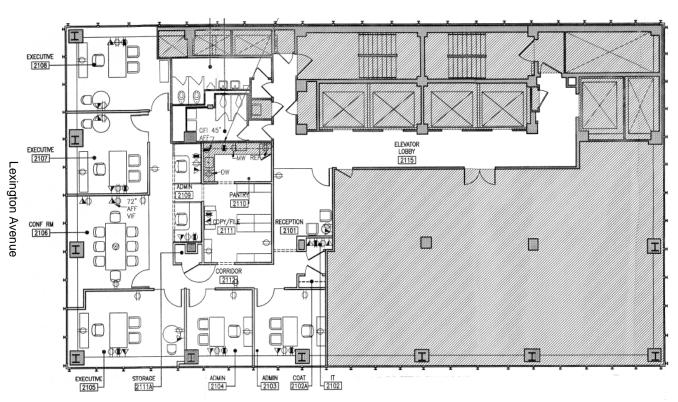

East 54th Street