

PRIVATE OFFICE 3 WORK STATION (2'6" X 5') 8 CONFERENCE ROOM (10P) 1 STORAGE 1 PANTRY/COFFEE BAR 2 WELLNESS ROOM 1 IT CLOSET 1 RECEPTION 1

OTAL	HEADCOUNT	11
OTAL	RSF	3,349


53NO STREET


KEY PLAN

S1ST STREET

SCALE: N.T.S.

AS-BUILT SUITE 25A FLOOR 25 75 ROCKEFELLER PLAZA NEW YORK, NEW YORK

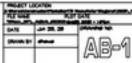

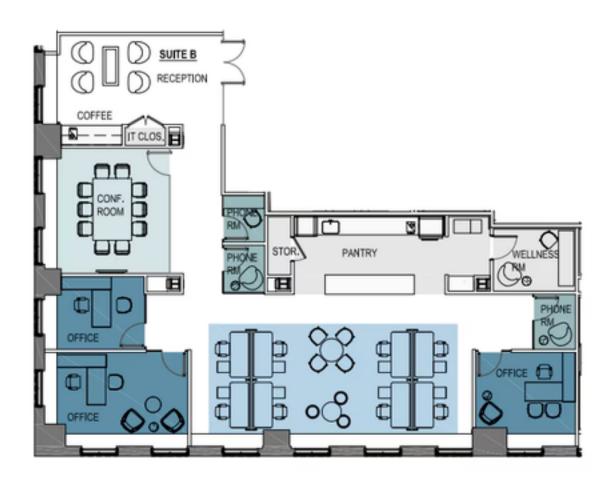

LEGEND

PRIVATE OFFICE			
WORK STATION (2'6" X 5')			
CONFERENCE ROOM (10P)			
PHONE ROOMS	3		
STORAGE			
PANTRY/COFFEE BAR			
WELLNESS ROOM			
IT CLOSET			
RECEPTION			
TOTAL HEADCOUNT	11		
TOTAL RSF 4,453			

KEY PLAN

SZAD STREET



SYST STREET

SCALE: N.T.S.

FLOOR 25 75 ROCKEFELLER PLAZA NEW YORK, NEW YORK

