



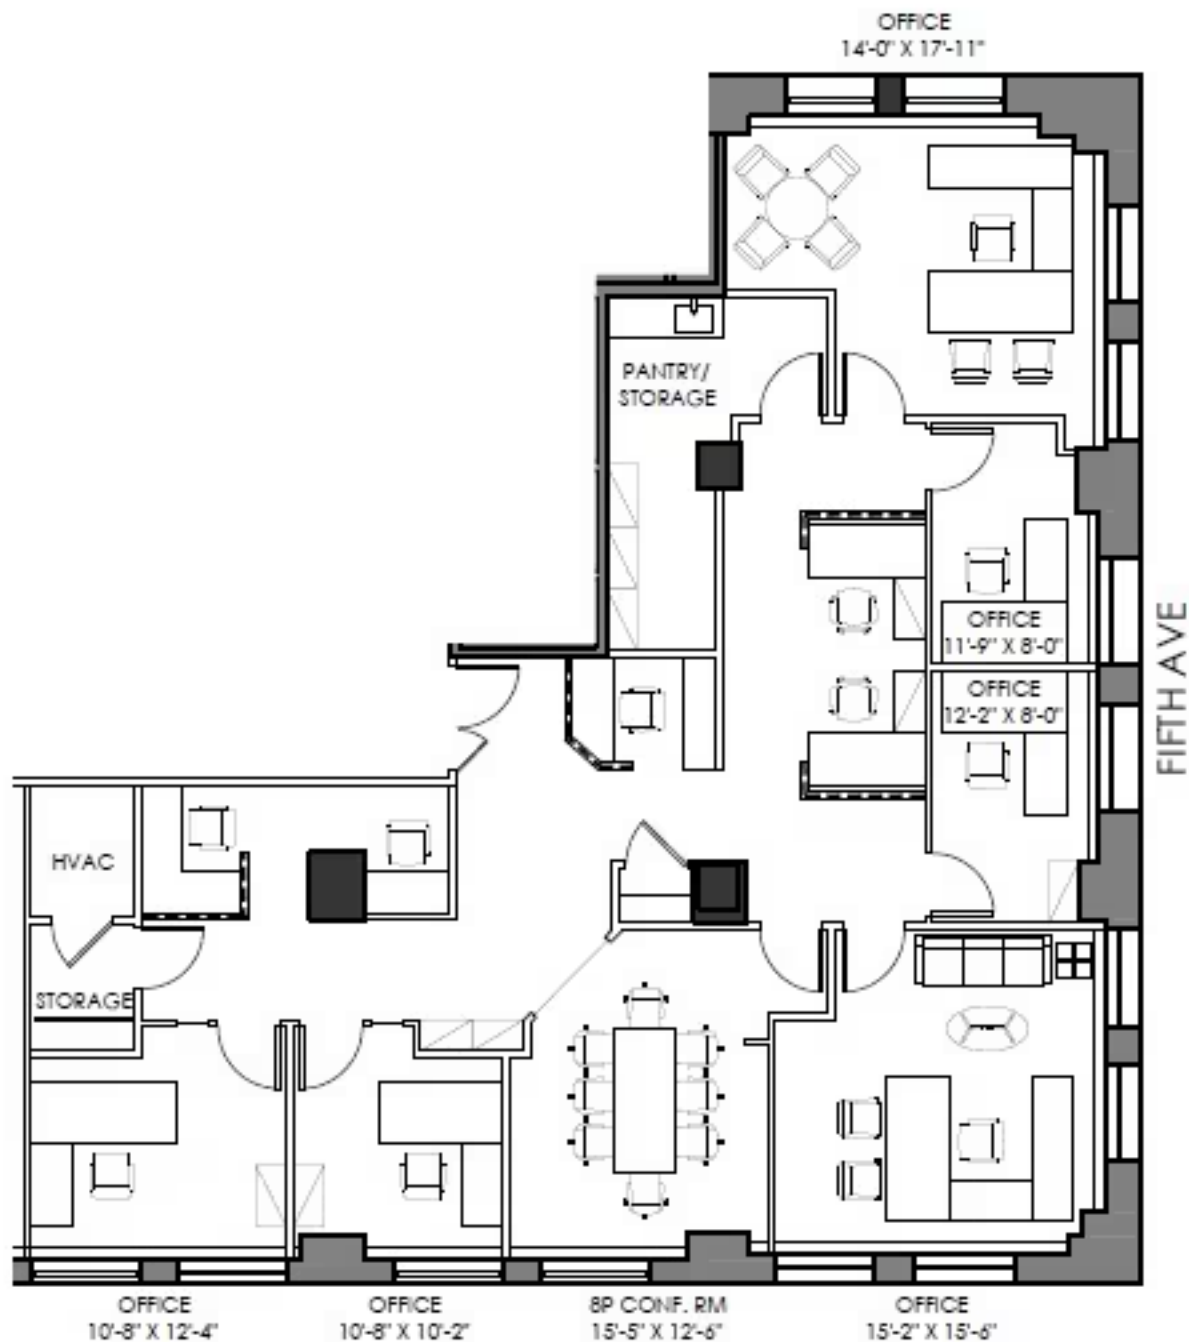

SPACE SUMMARY	
OFFICE	6
WORKSTATIONS	4
RECEPTION	1
TOTAL HEAD COUNT	11
8P CONFERENCE ROOM	1
PANTRY/STORAGE	1
CLOSET/STORAGE	2

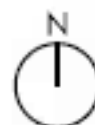

500 5TH AVENUE

SUITE 5100
3,630 RSF

AS-BUILT

SCALE: NTS