



52nd STREET

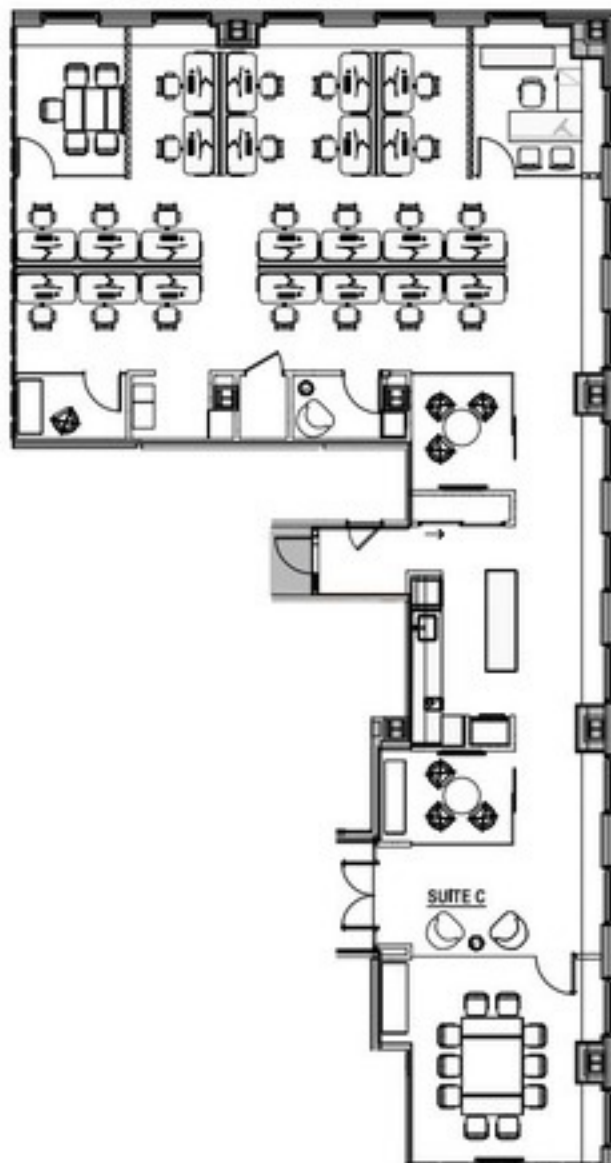

KEY PLAN:

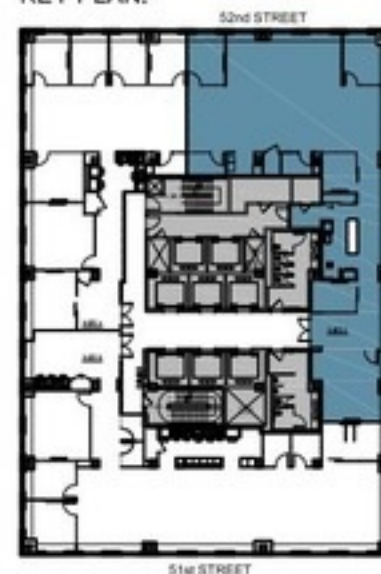

51st STREET

SCALE: N.T.S.

AS-BUILT
22ND FLOOR - SUITE 22C

FLOOR 22
75 ROCKEFELLER PLAZA
NEW YORK, NEW YORK

PROJECT LOCATION	
KEY LINE	KEY DATE
DATE	Jan 14, 20
DESIGN BY	CHANGING
AB-1	