


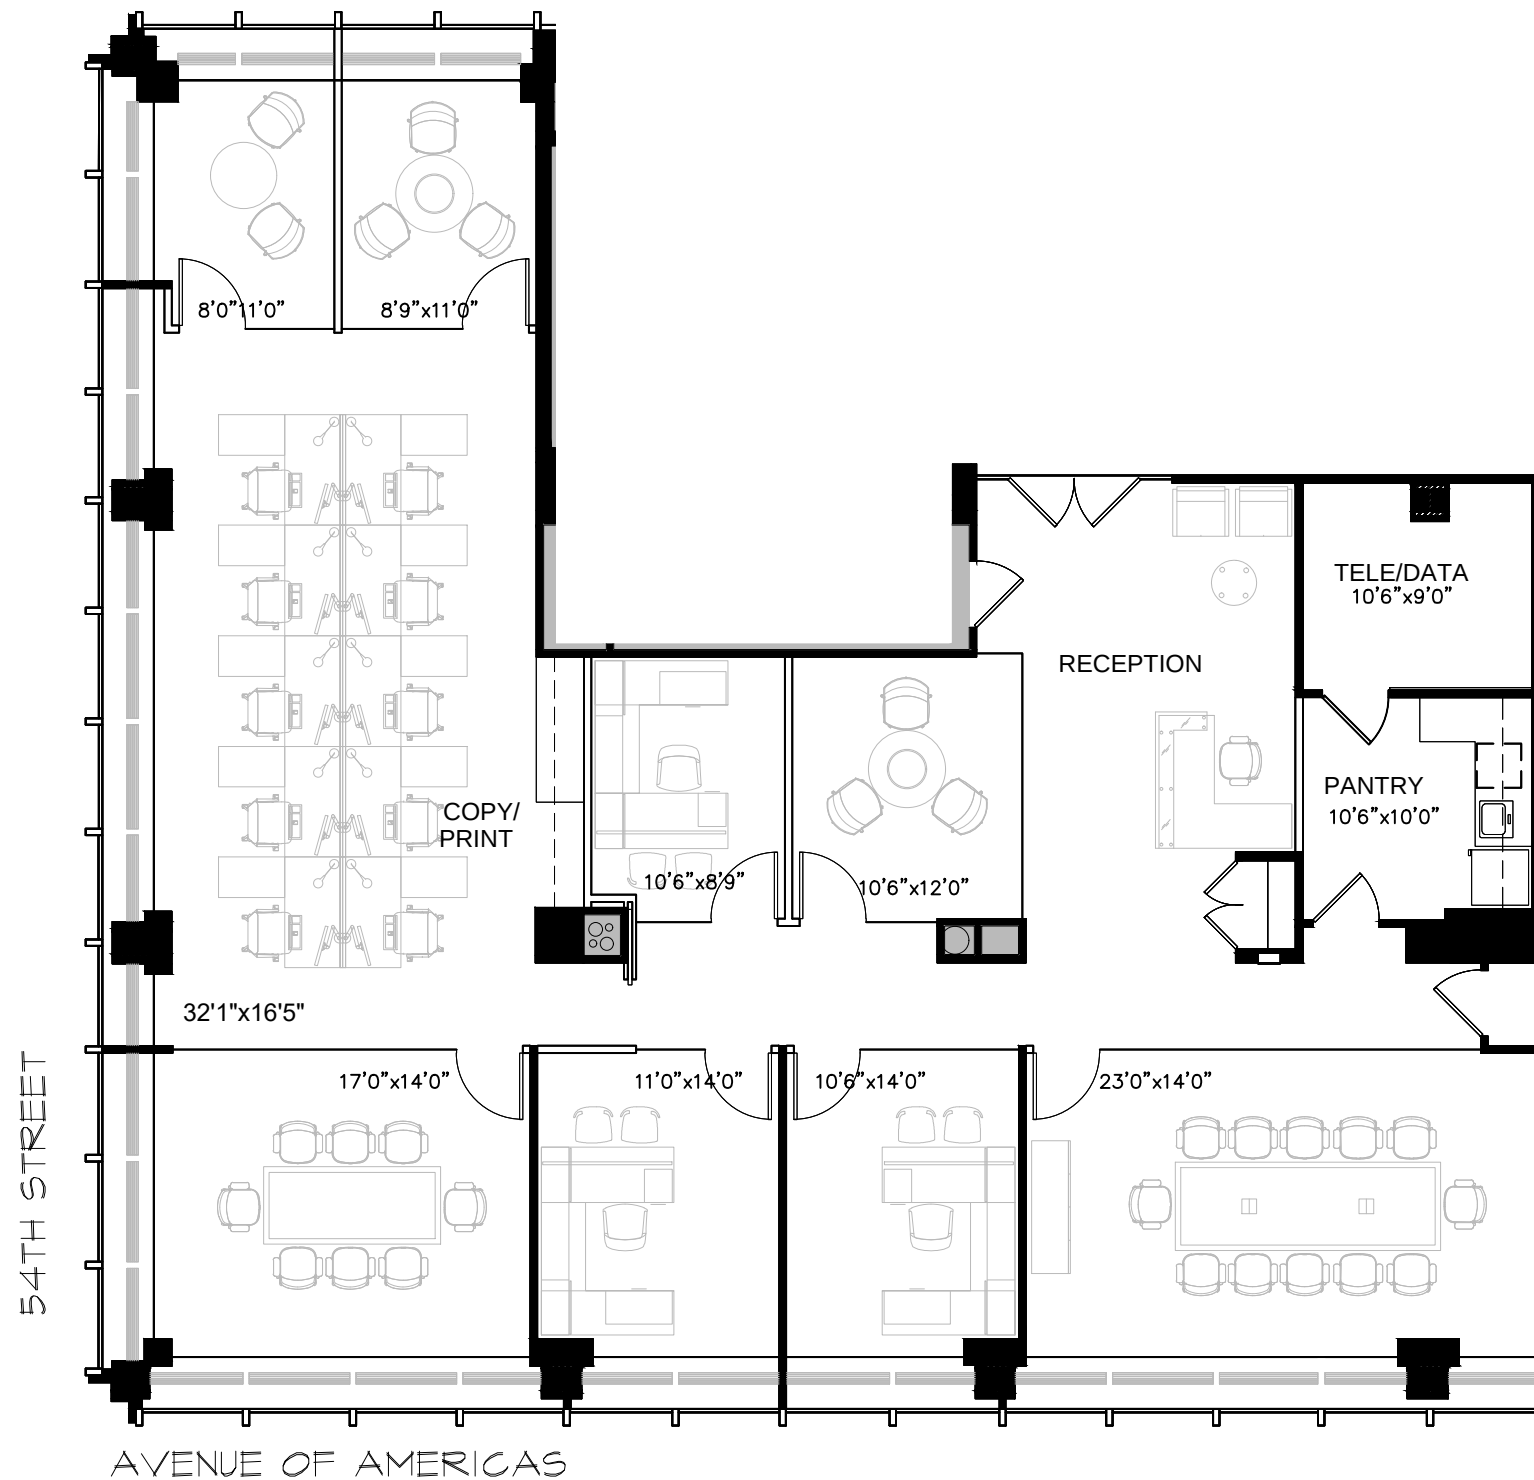

AVENUE OF AMERICAS

* ALL DIMENSIONS ARE APPROXIMATE

**NOTE: FURNITURE SHOWN FOR SCALE PURPOSES ONLY. NOT INCLUDED IN AS BUILT CONDITIONS.

SCALE: 1/8"=1'-0"

22nd FLOOR- SUITE 2210 AS-BUILT

1330 Avenue of the Americas
Suite 2210
New York, NY

PROJECT LOCATION		
22nd Floor	Construction	2210 Avenue of the Americas
FILE NAME	PLOT DATE	
2210-22nd Floor Suite 2210.dwg	Sep 21, 2025	
DATE	DRAWING NO.	
Sep 21, 25	DS-1	
DRAWN BY	DBarone	