
WEST 35TH STREET



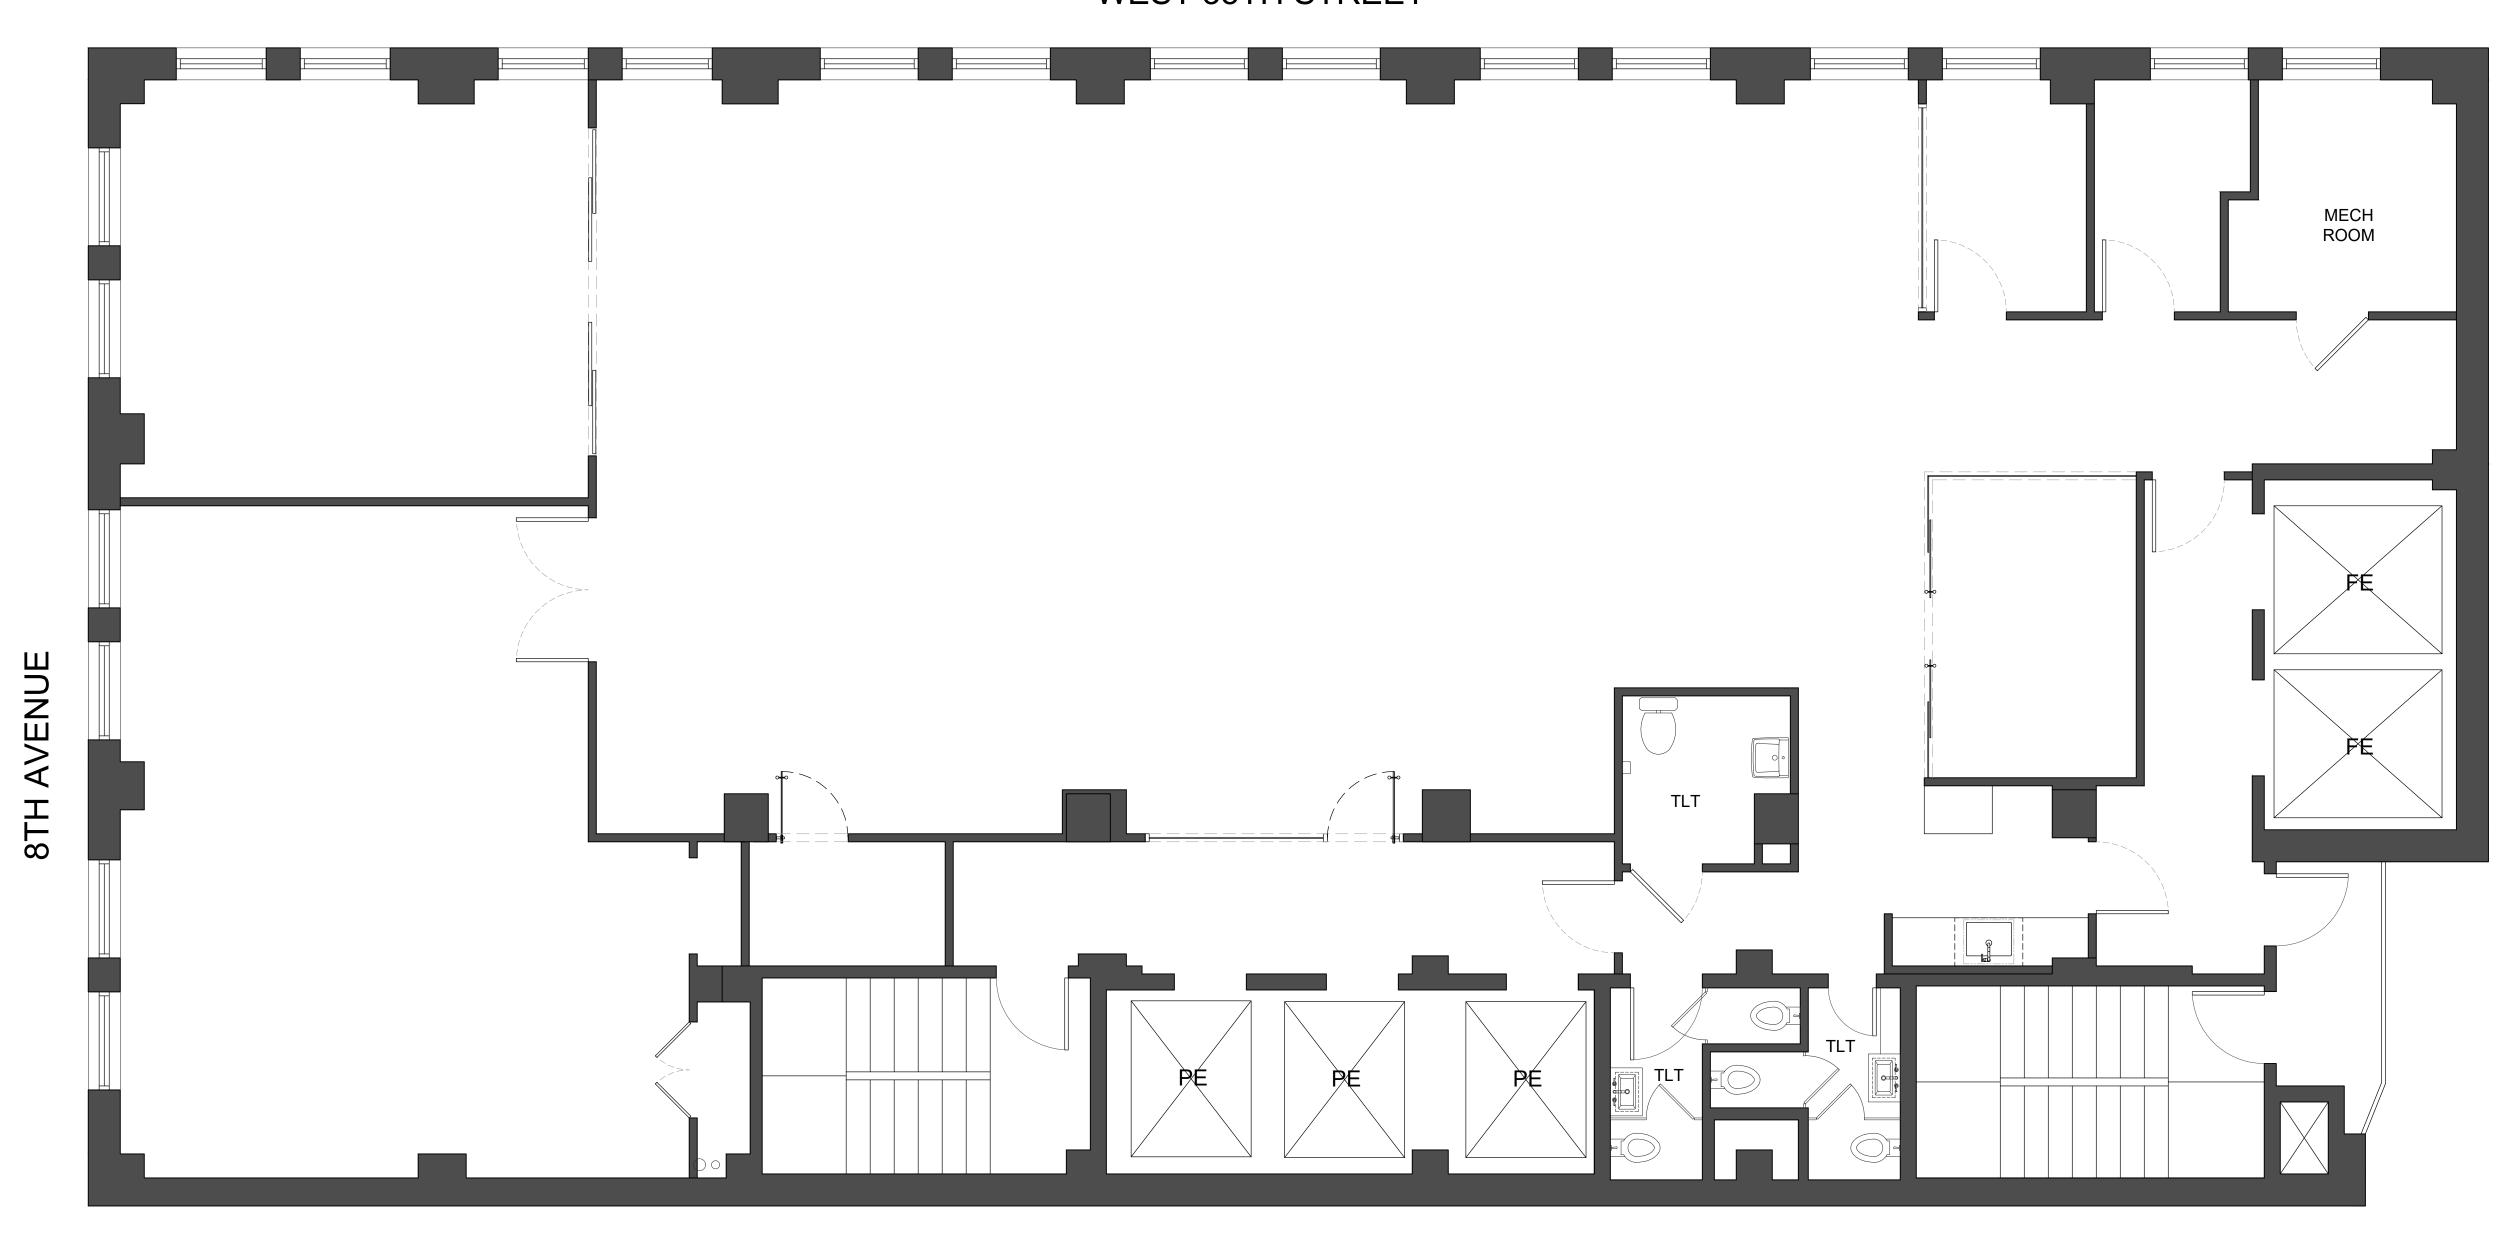

SCALE: AS NOTED PROJECT: 494 8TH AVENUE, NEW YORK, NY 10001

DRAWING: 11TH FLOOR PLAN

AS BUILT