


# 41 MADISON

## Floor 33

### As Built Floor Plan

**9,096 Sq. Ft.**  
**Partial Floor Available**  
**August 1, 2025**

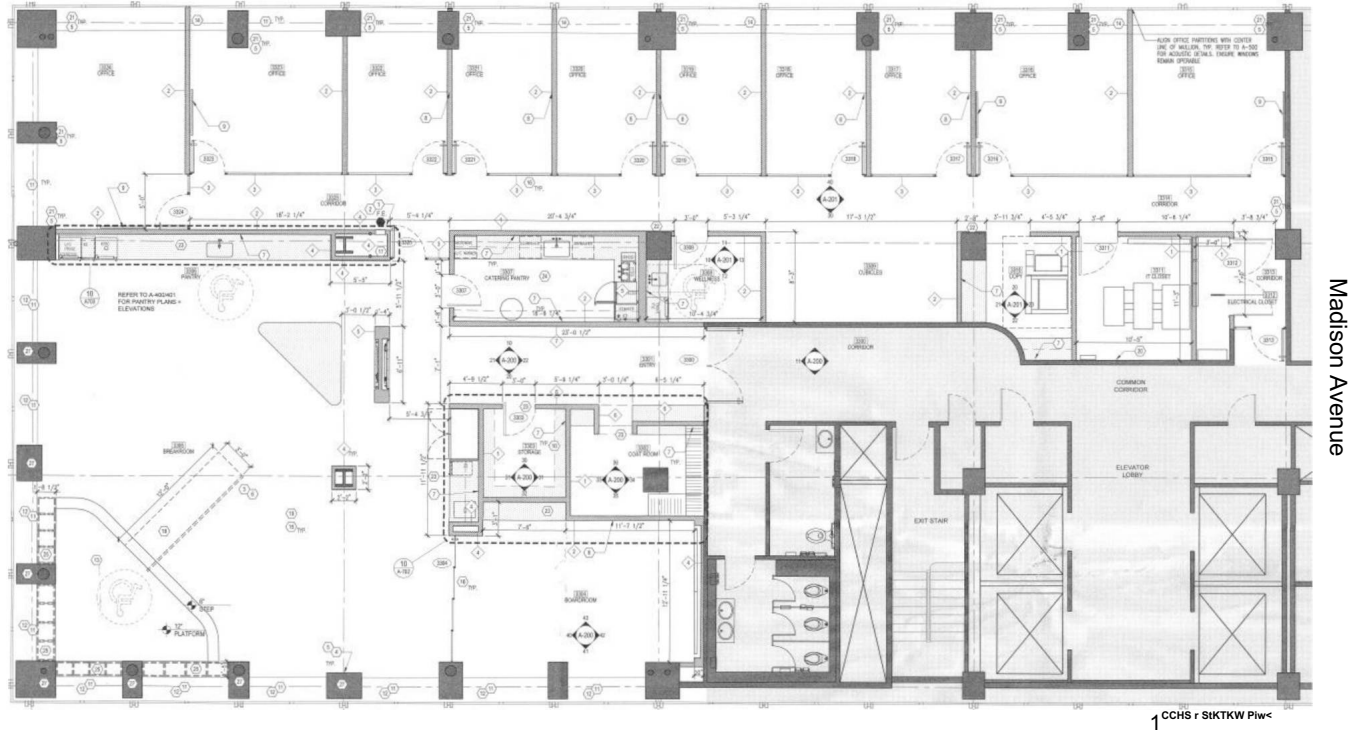

East 26<sup>th</sup> Street