


133 EAST 58 STREET


Partial 3rd Floor | Suite 307 | As-Built | 985 SF

MID TOWN EAST DISTRICT

KEY PLAN

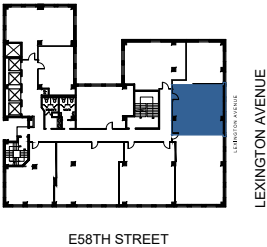

E58TH STREET

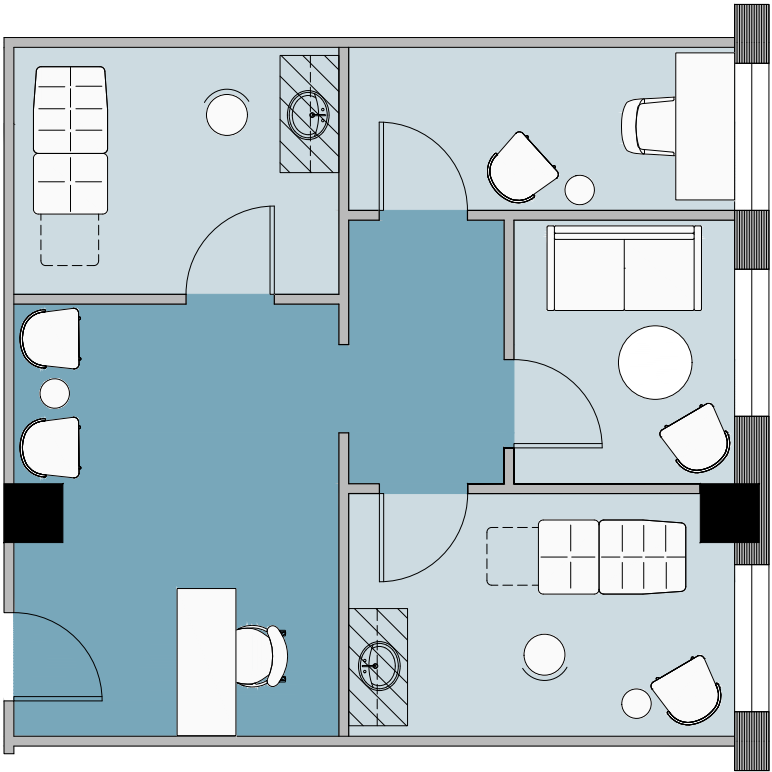

SUITE 307

WORK PLACE		PEOPLE
OFFICE/EXAM ROOM		4
TOTAL		4
SUPPORT		AREAS
ADMIN/RECEPTION		1
TOTAL		1