


845 Third Avenue

Floor 17
As Built Floor Plan

2,010 Sq. Ft.
Partial Floor Available

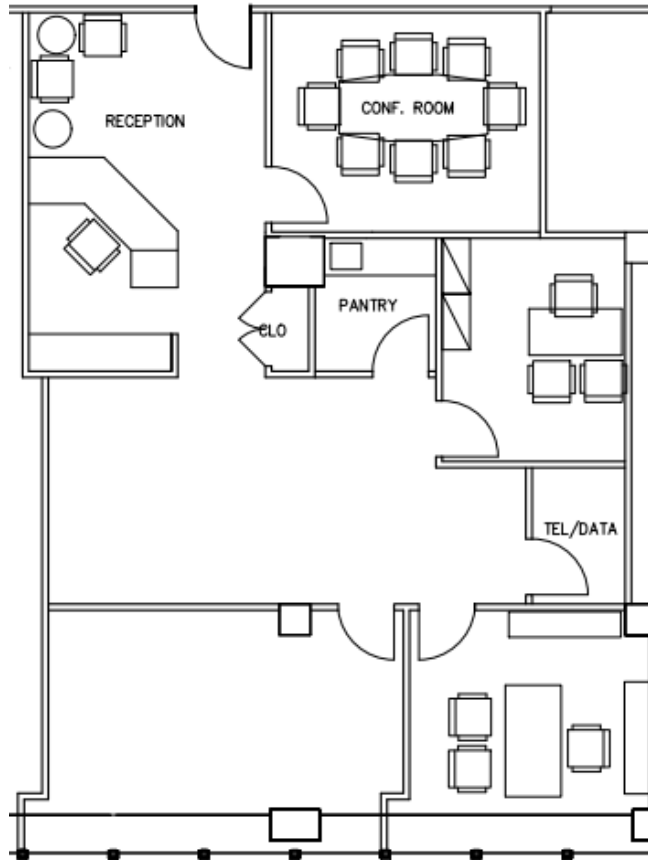

Third Avenue

Space location on the 17th Floor

