
845 Third Avenue

Floor 19 As Built Plan

2,960 Sq. Ft.
Partial Floor Available

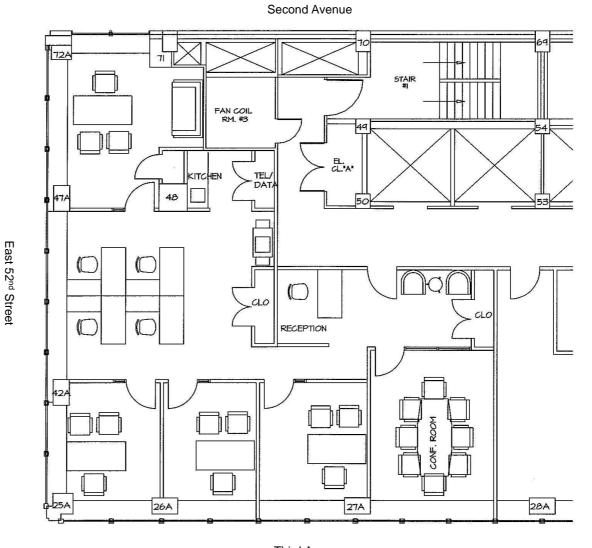

East 51st Street

Third Avenue