


355 Lexington Avenue

Floor 4
As Built Plan

3,196 Sq. Ft.
Partial Floor Available
Immediately

Asking: \$55 per RSF

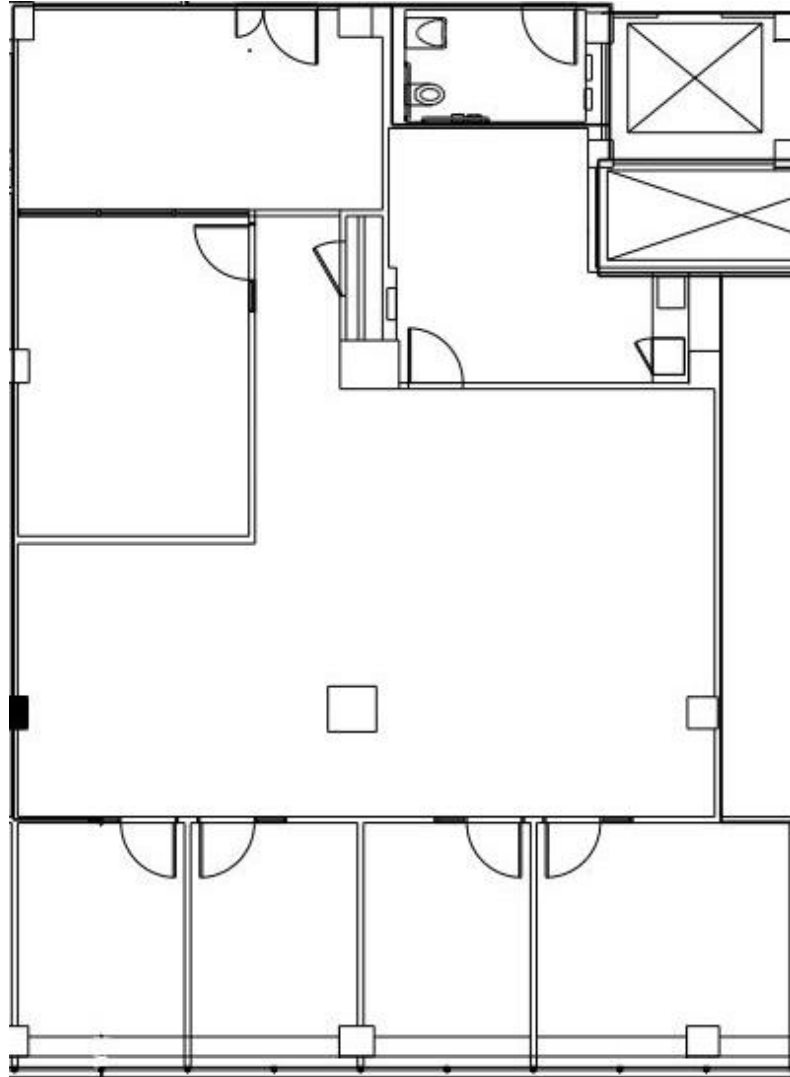

East 40th St