


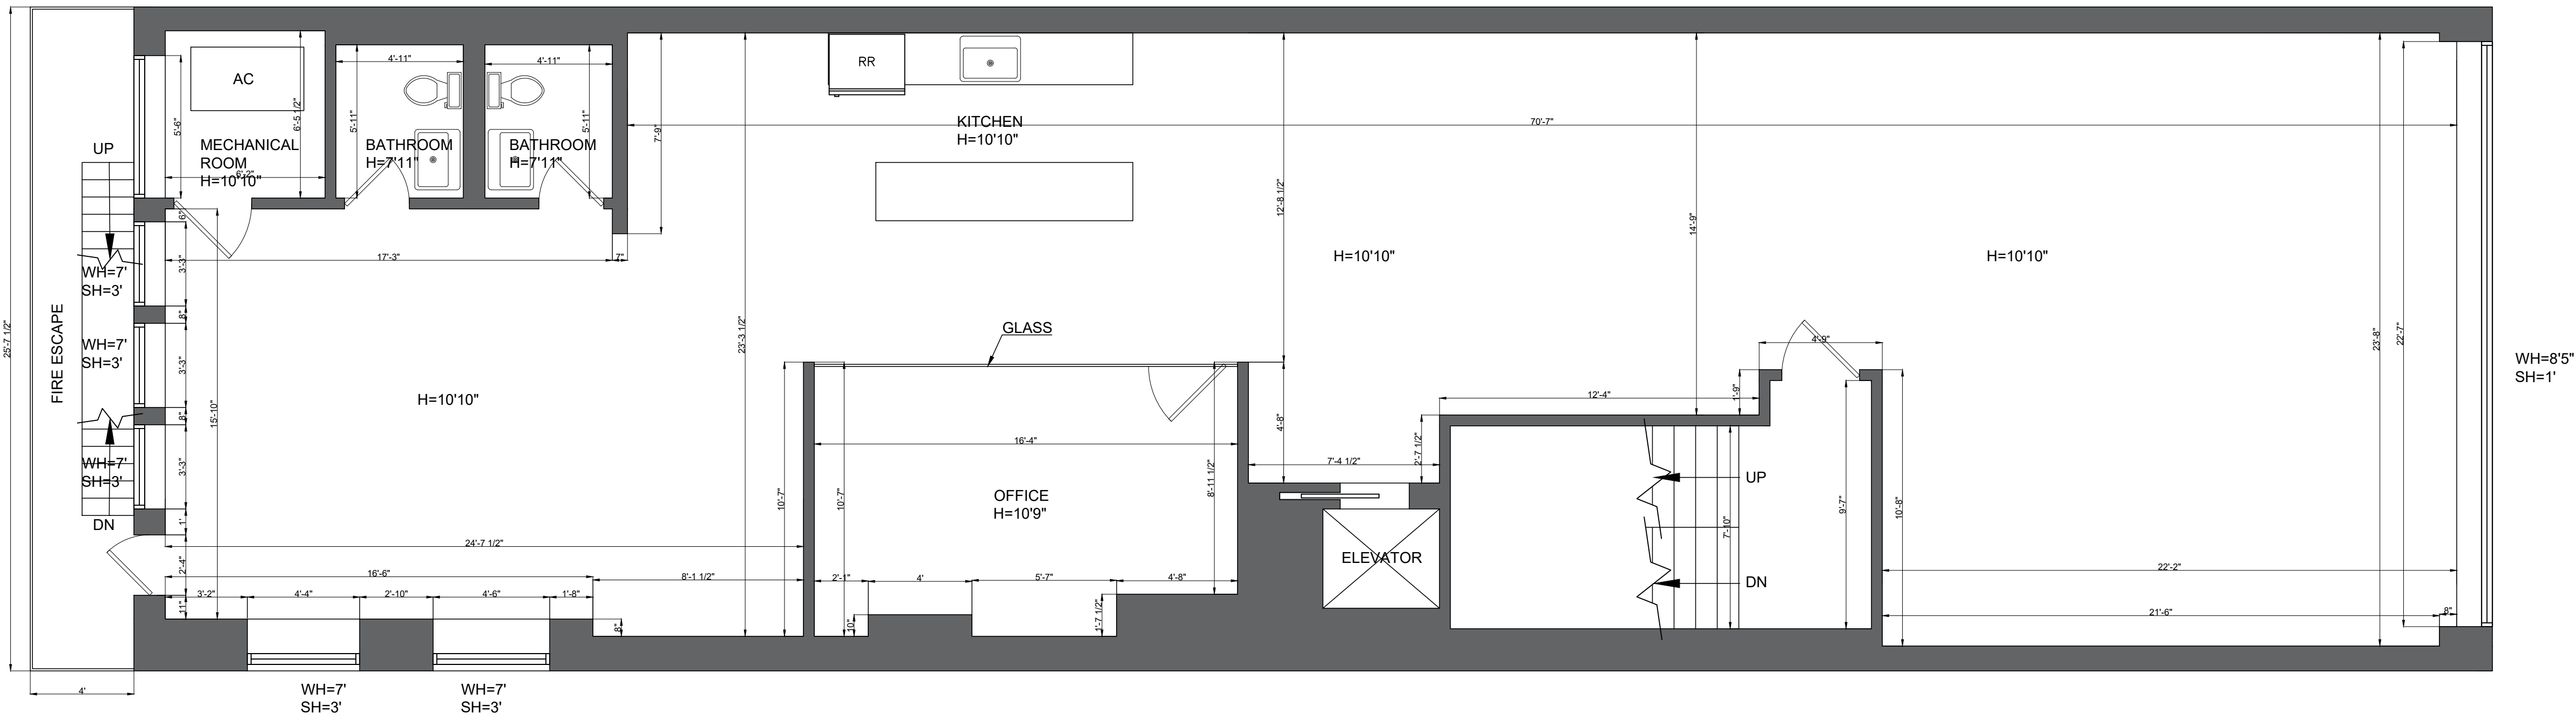

Project

26 W 23rd St,
New York, NY 10010

Drawing

First floor space plan

**As-built
Floor Plans**

A - 001.01

Area 2332 sq.ft.

Scale 1/4":1'

Date 7/29/2023

Drawn By M.O.

Notes