


SPACE SUMMARY	
SPACE TYPE	QTY
OFFICES	4
OPEN AREA	2
RECEPTION	1
12P CONFERENCE ROOM	1
PANTRY/COPY	1
IT	1
COATS	1

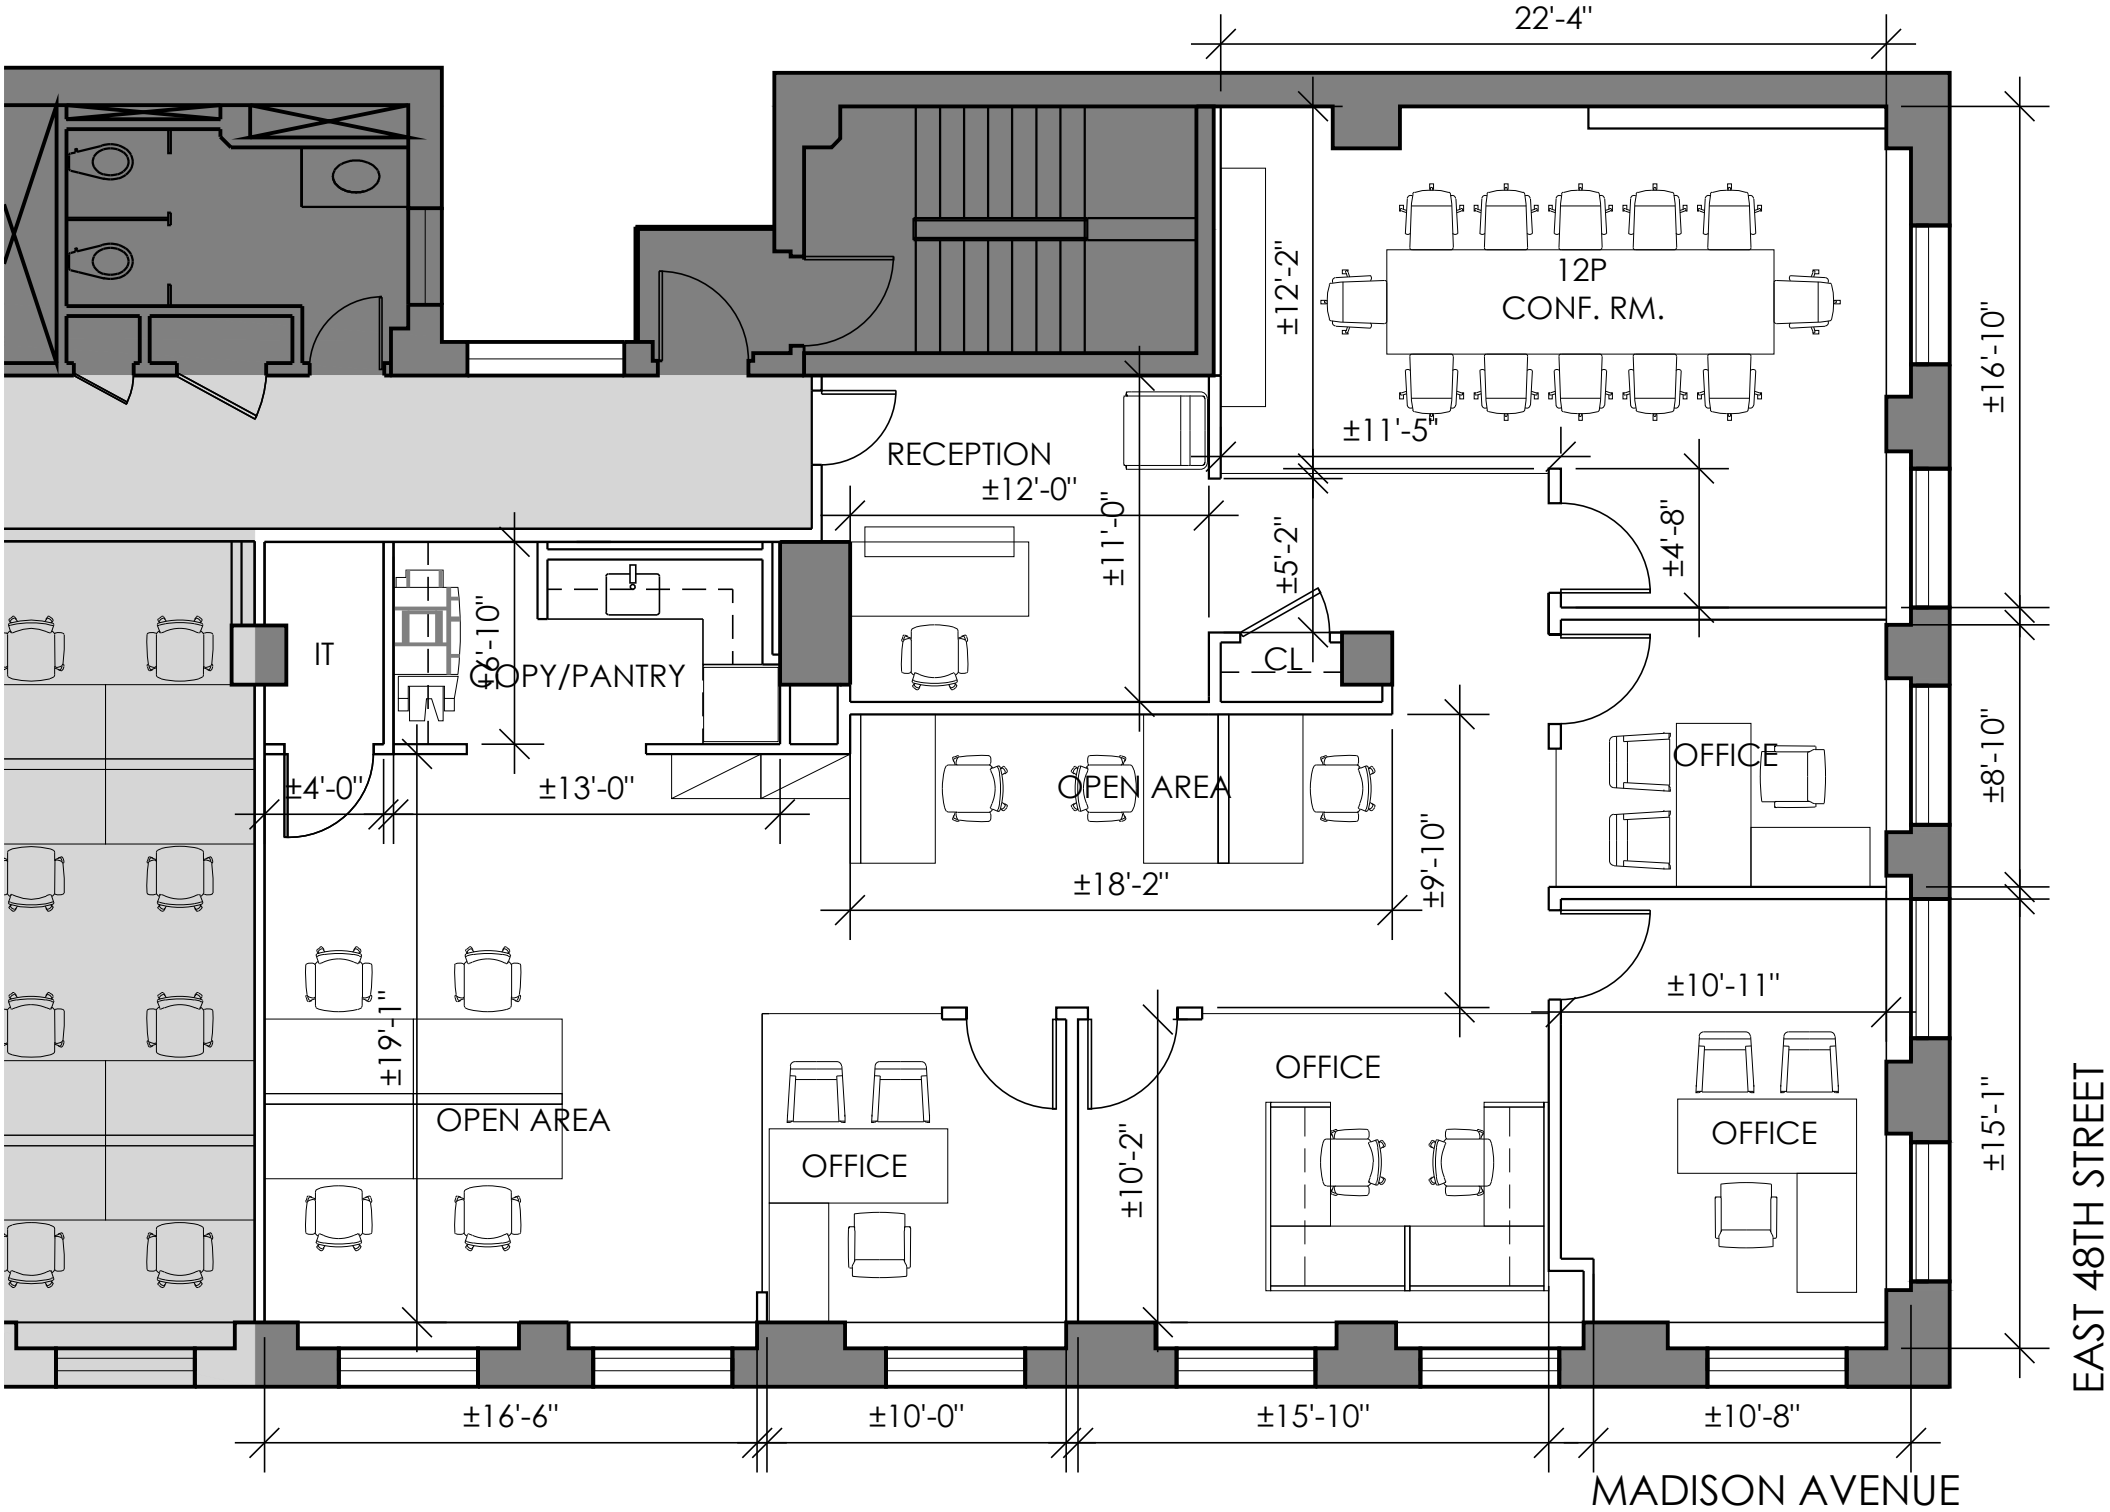

-- ALL DIMENSIONS AND CONDITIONS ARE --
APPROXIMATE AND SUBJECT TO FIELD VERIFICATION

SUITE 9D
AS-BUILT

DS400
400 MADISON AVENUE
9TH FLOOR