



PARTIAL FLOOR 19

SUITE 1900-04
3,785 SF



BUILDING EXTERIOR



LOBBY


AVAILABILITY

- Built Space
- Arranged Possession

PROPERTY FEATURES

- Highly desirable location, one block from Grand Central Terminal
- Green roofs and exclusive outdoor terraces
- Outdoor plaza featuring a zinc green wall
- Renovated lobby
- Certified Gold under LEED v4 Existing Buildings: Operations + Maintenance

AS-BUILT PLAN

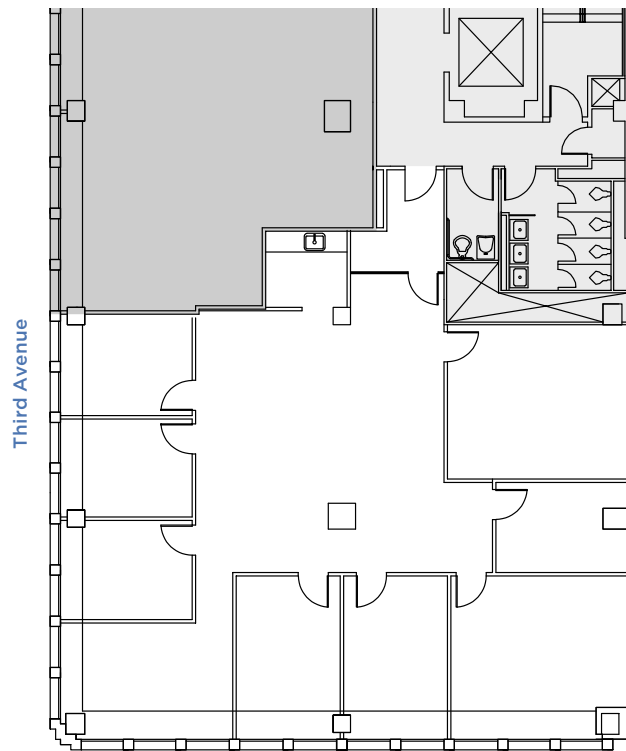

Third Avenue

East 42nd Street

