


641 Lexington Avenue

Floor 31
As Built Plan

6,690 Sq. Ft.
Entire Floor Available
Immediately

Asking: \$65 per RSF

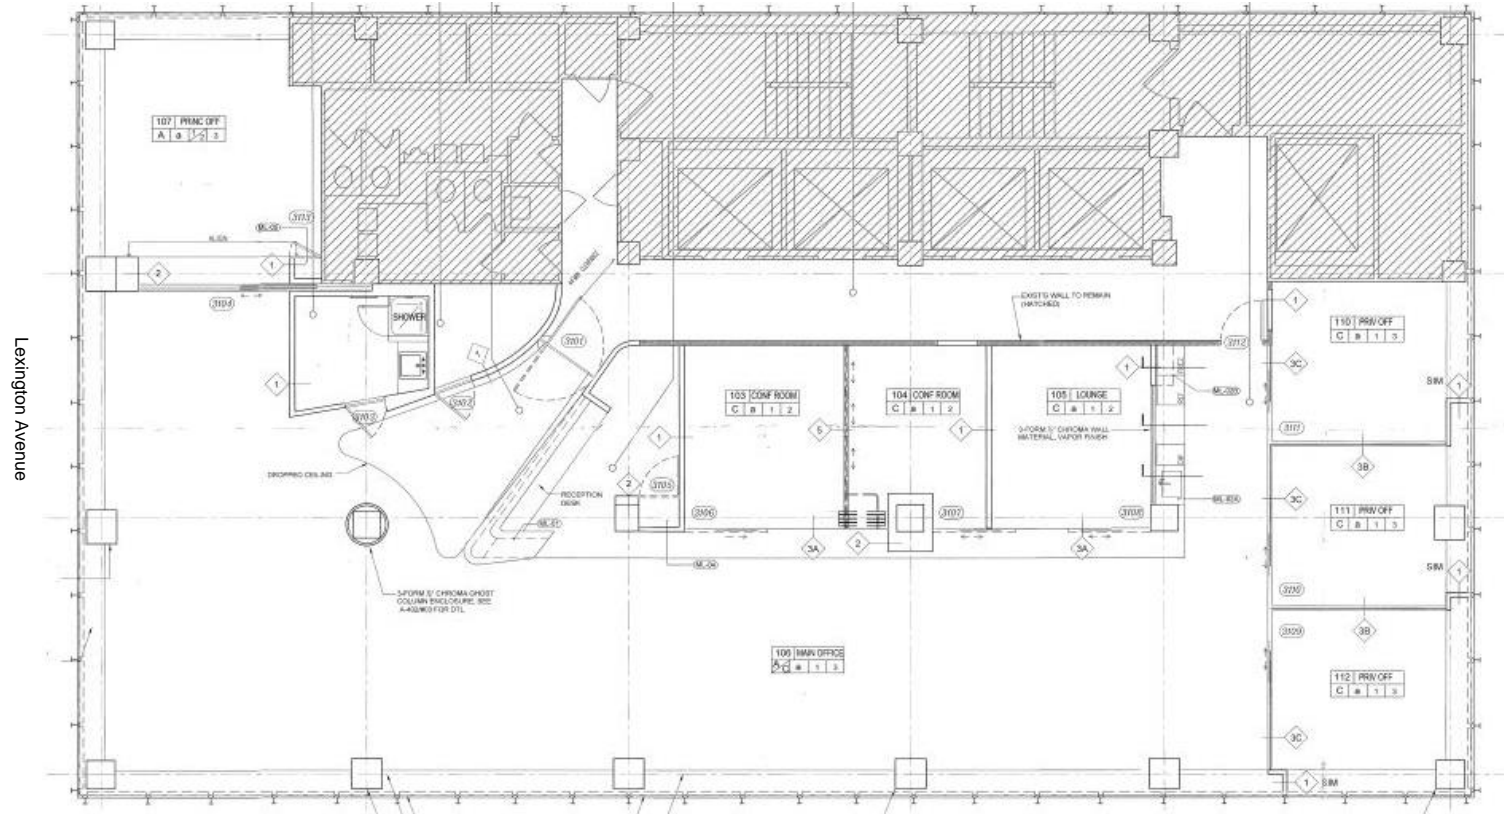

East 54th Street