


AS BUILT FLOOR PLAN (FLOOR: 9)

SCALE: 1/4" = 1'-0"



KEY PLAN
SCALE: NTS

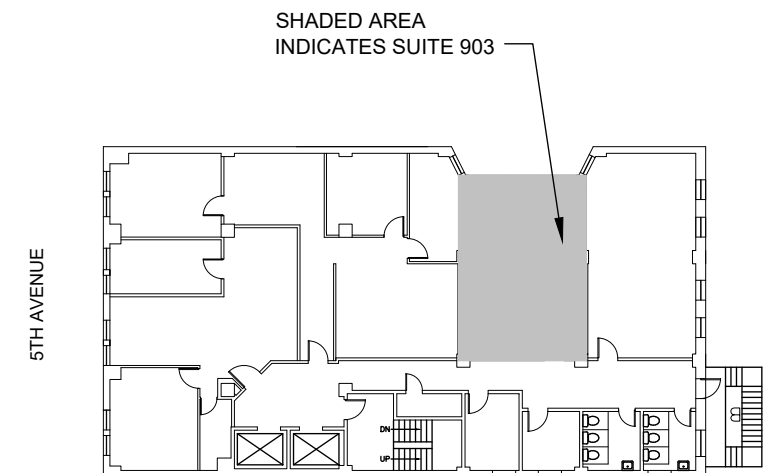

BUILDING
AS BUILT PLAN
362 FIFTH AVE, SUITE 903
NEW YORK, NY

SKETCH
AS BUILT