



Full Floor
Opportunities in
NOMAD

44
W 28

Entire **14th Floor** — **12,083 RSF**

Possession — **5 & 3 Immediate** | **14 1/1/2025**

Term — **Negotiable**



Pre-Built Floors



Creative installations




Full Floor Presence




Test-Fit — Open Layout

WEST 28TH STREET

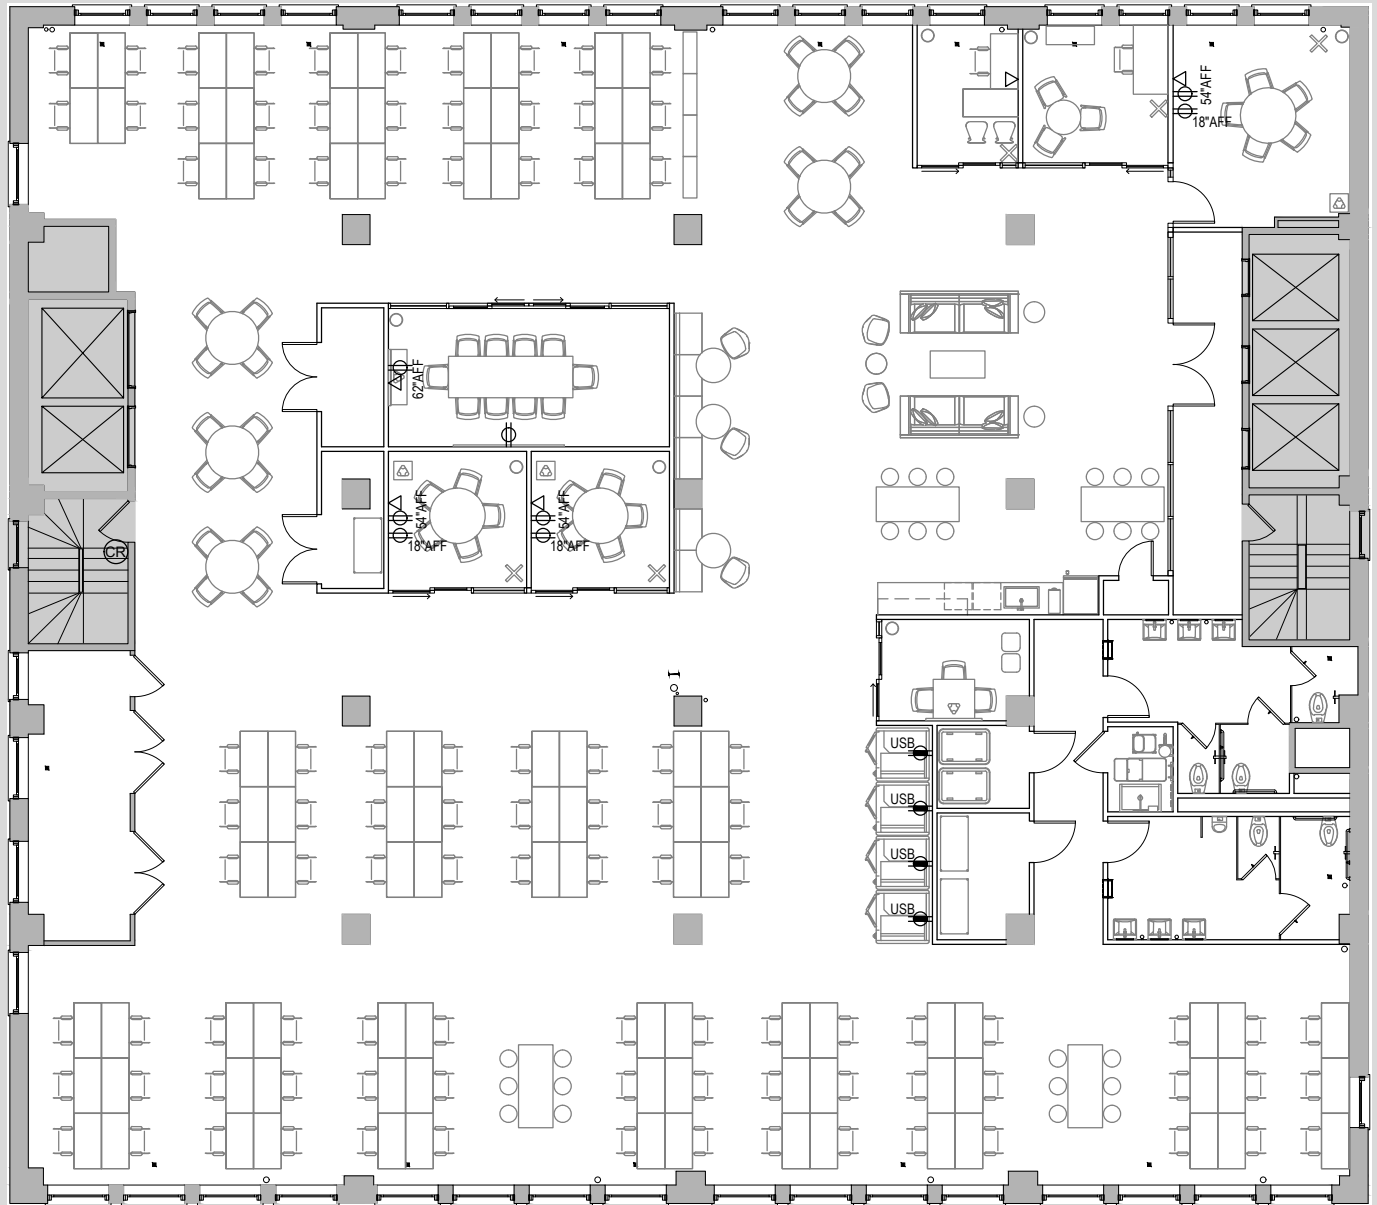

As-Built — 14th Floor

WEST 28TH STREET

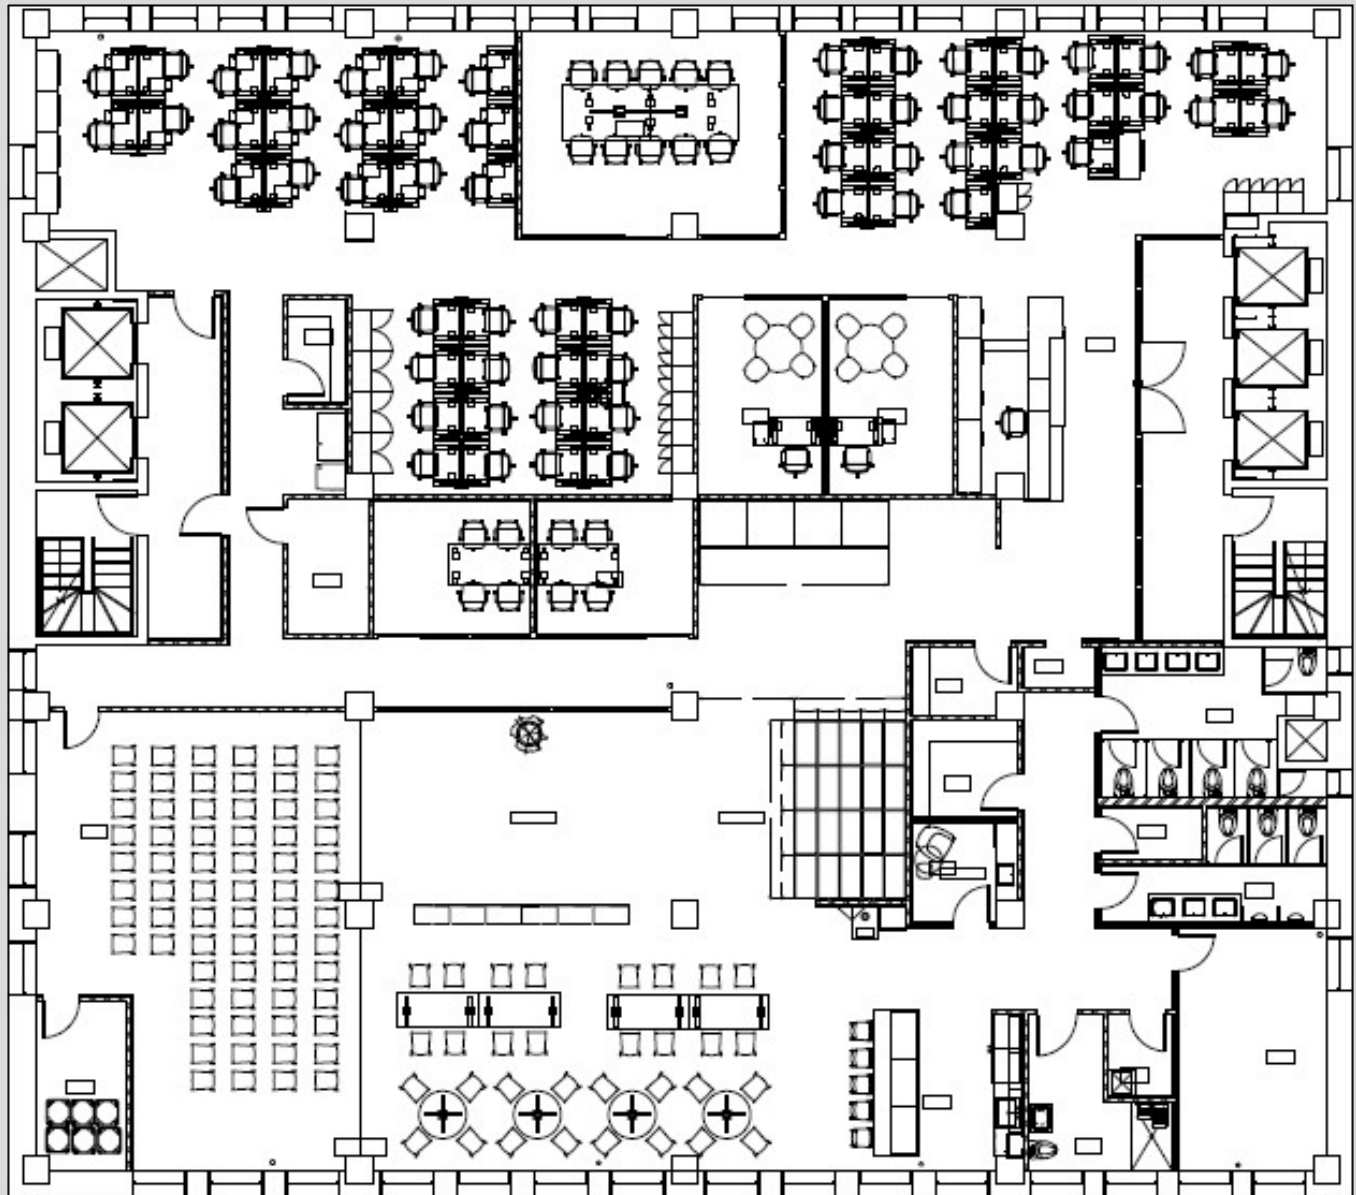





44
w28
