

# EMPIRE STATE BUILDING



Property of Empire State Realty Trust, used with permission.



# Partial 60th Floor 13,171 RSF

Possession  
**IMMEDIATE**

Term  
**THROUGH 2/2028**

- Fully built and Furnished
- Expansive views on 3 sides

**AS BUILT PLAN**

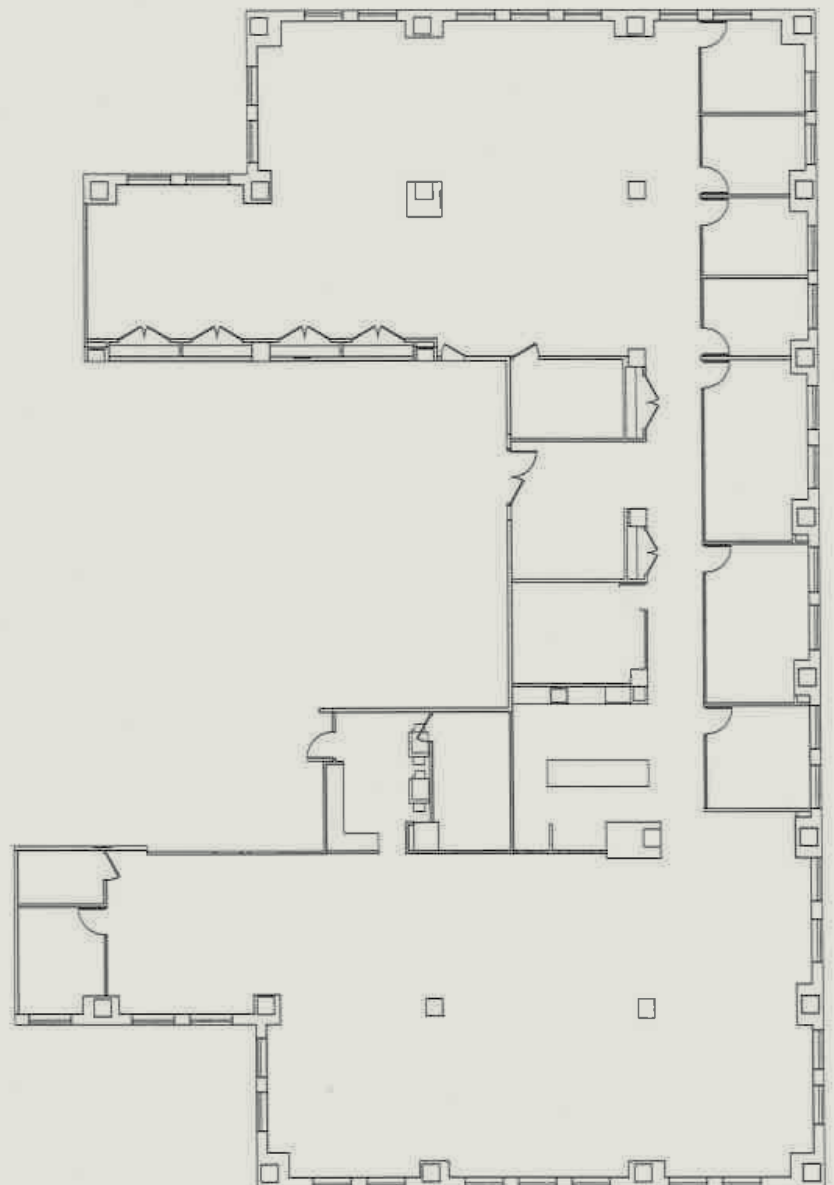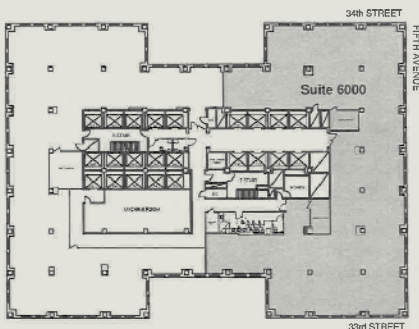





# EMPIRE STATE BUILDING