

EMPIRE STATE BUILDING



60th Floor



13,171 RSF

Possession
IMMEDIATE

Term
THROUGH 2/2028

- Fully built and Furnished
- Expansive views on 3 sides

AS BUILT PLAN

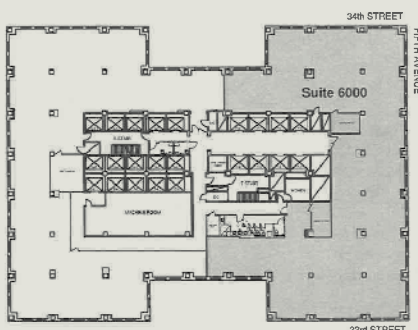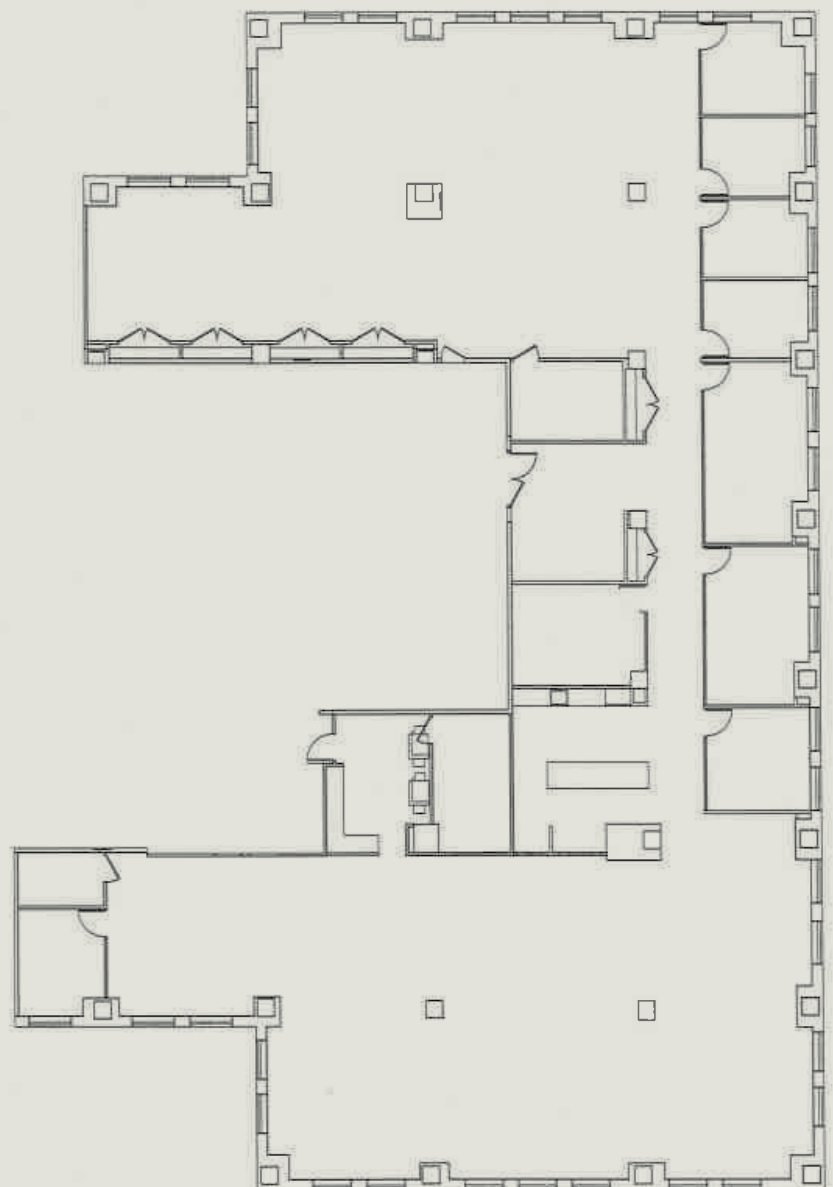





EMPIRE STATE BUILDING