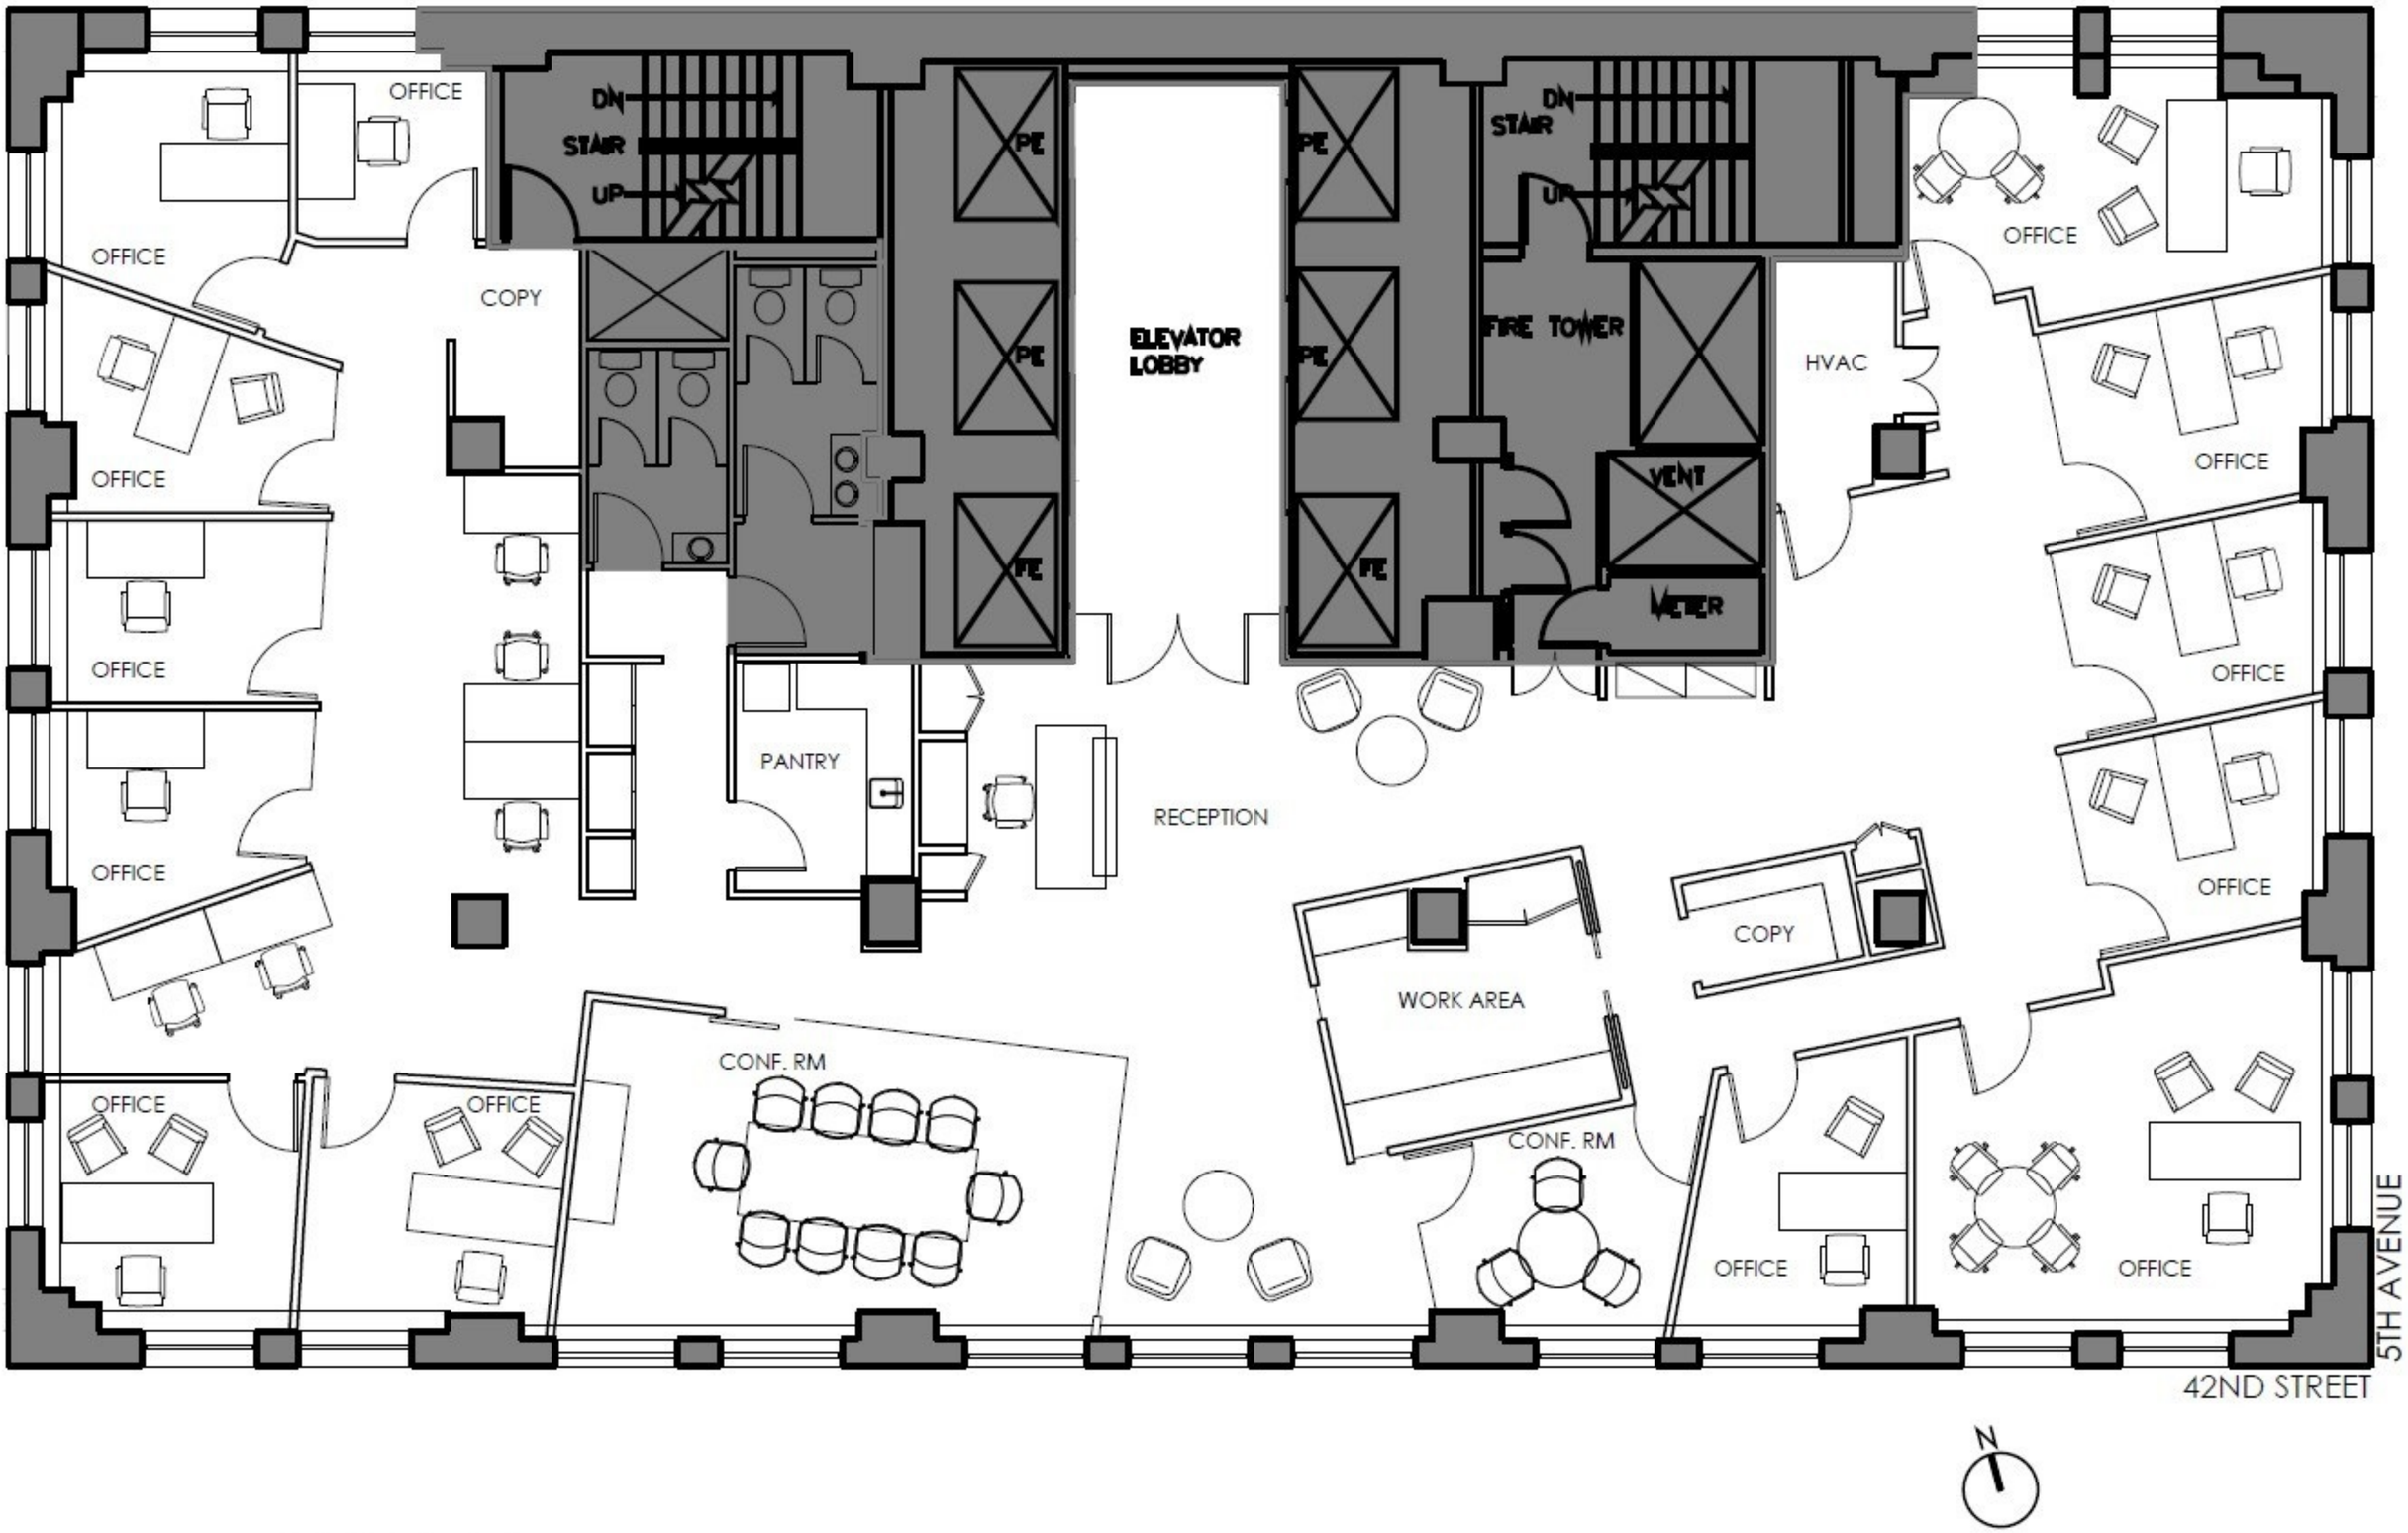

500 FIFTH AVENUE

53RD FLOOR

AS-BUILT PLAN

DWG: SSK-500-53