


# 50 West 23rd Street

Space to Work

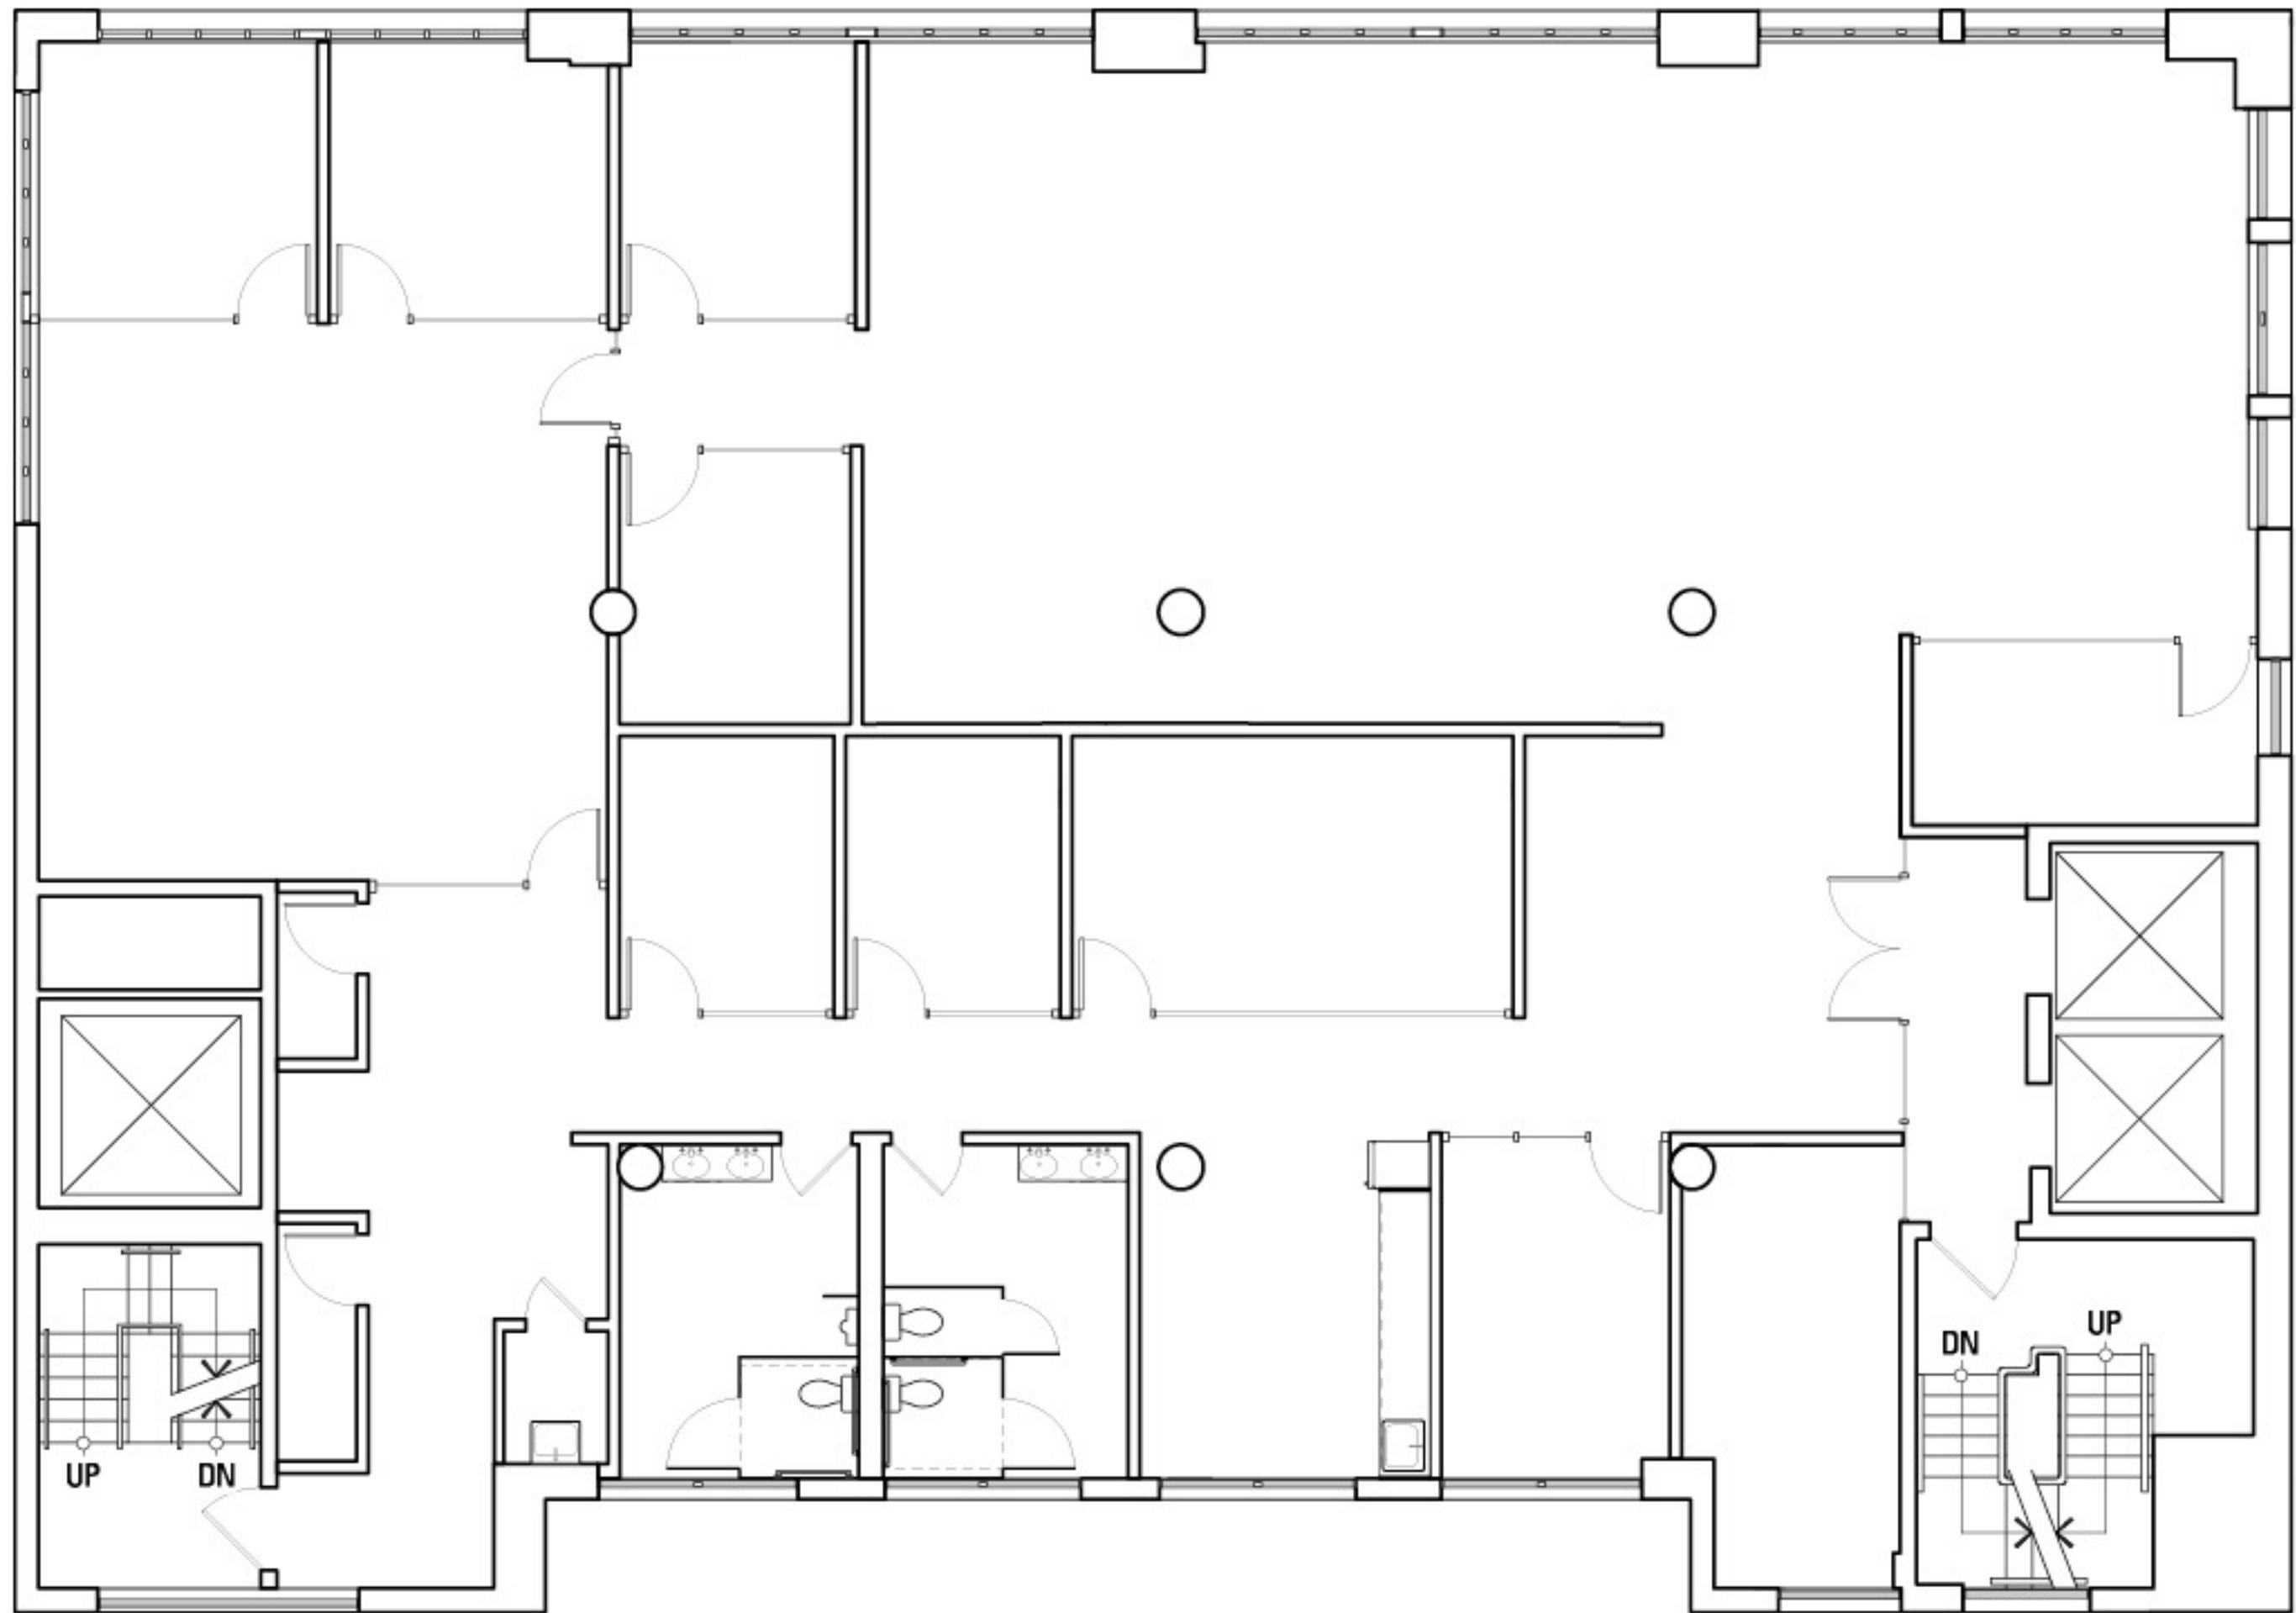

14th Floor – As Built

Total Square Footage: 7,785 RSF

