

PARTIAL FLOOR 25 9,579 SF





LOBBY

PLAZA & ENTRANCE

AVAILABILITY


- Superb Modern Buildout
- Open Work and Interior Private Office Layout
- Available July 2025

PROPERTY FEATURES

- New Landscaped Plaza, Building Entrance, and Lobby
- Elevator Modernization Including Destination Dispatch Controls
- New Energy-Efficient Curtain Wall With Floor-to-Ceiling Clear Glazing at Chamfered Corners
- New Low-Iron Energy-Efficient Casement Windows
- Certified LEED Gold Under LEED v4 Existing Buildings: Operations + Maintenance
- Located at the Convergence of Bryant Park and Corporate Row — Mere Minutes From Grand Central Terminal, 16 Subway Lines, and Some of NYC's Best Dining and Entertainment

AS-BUILT PLAN

West 45th Street

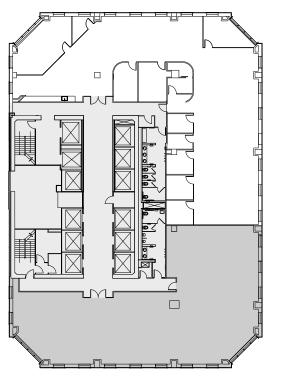

Avenue of the Americas

West 44th Street