


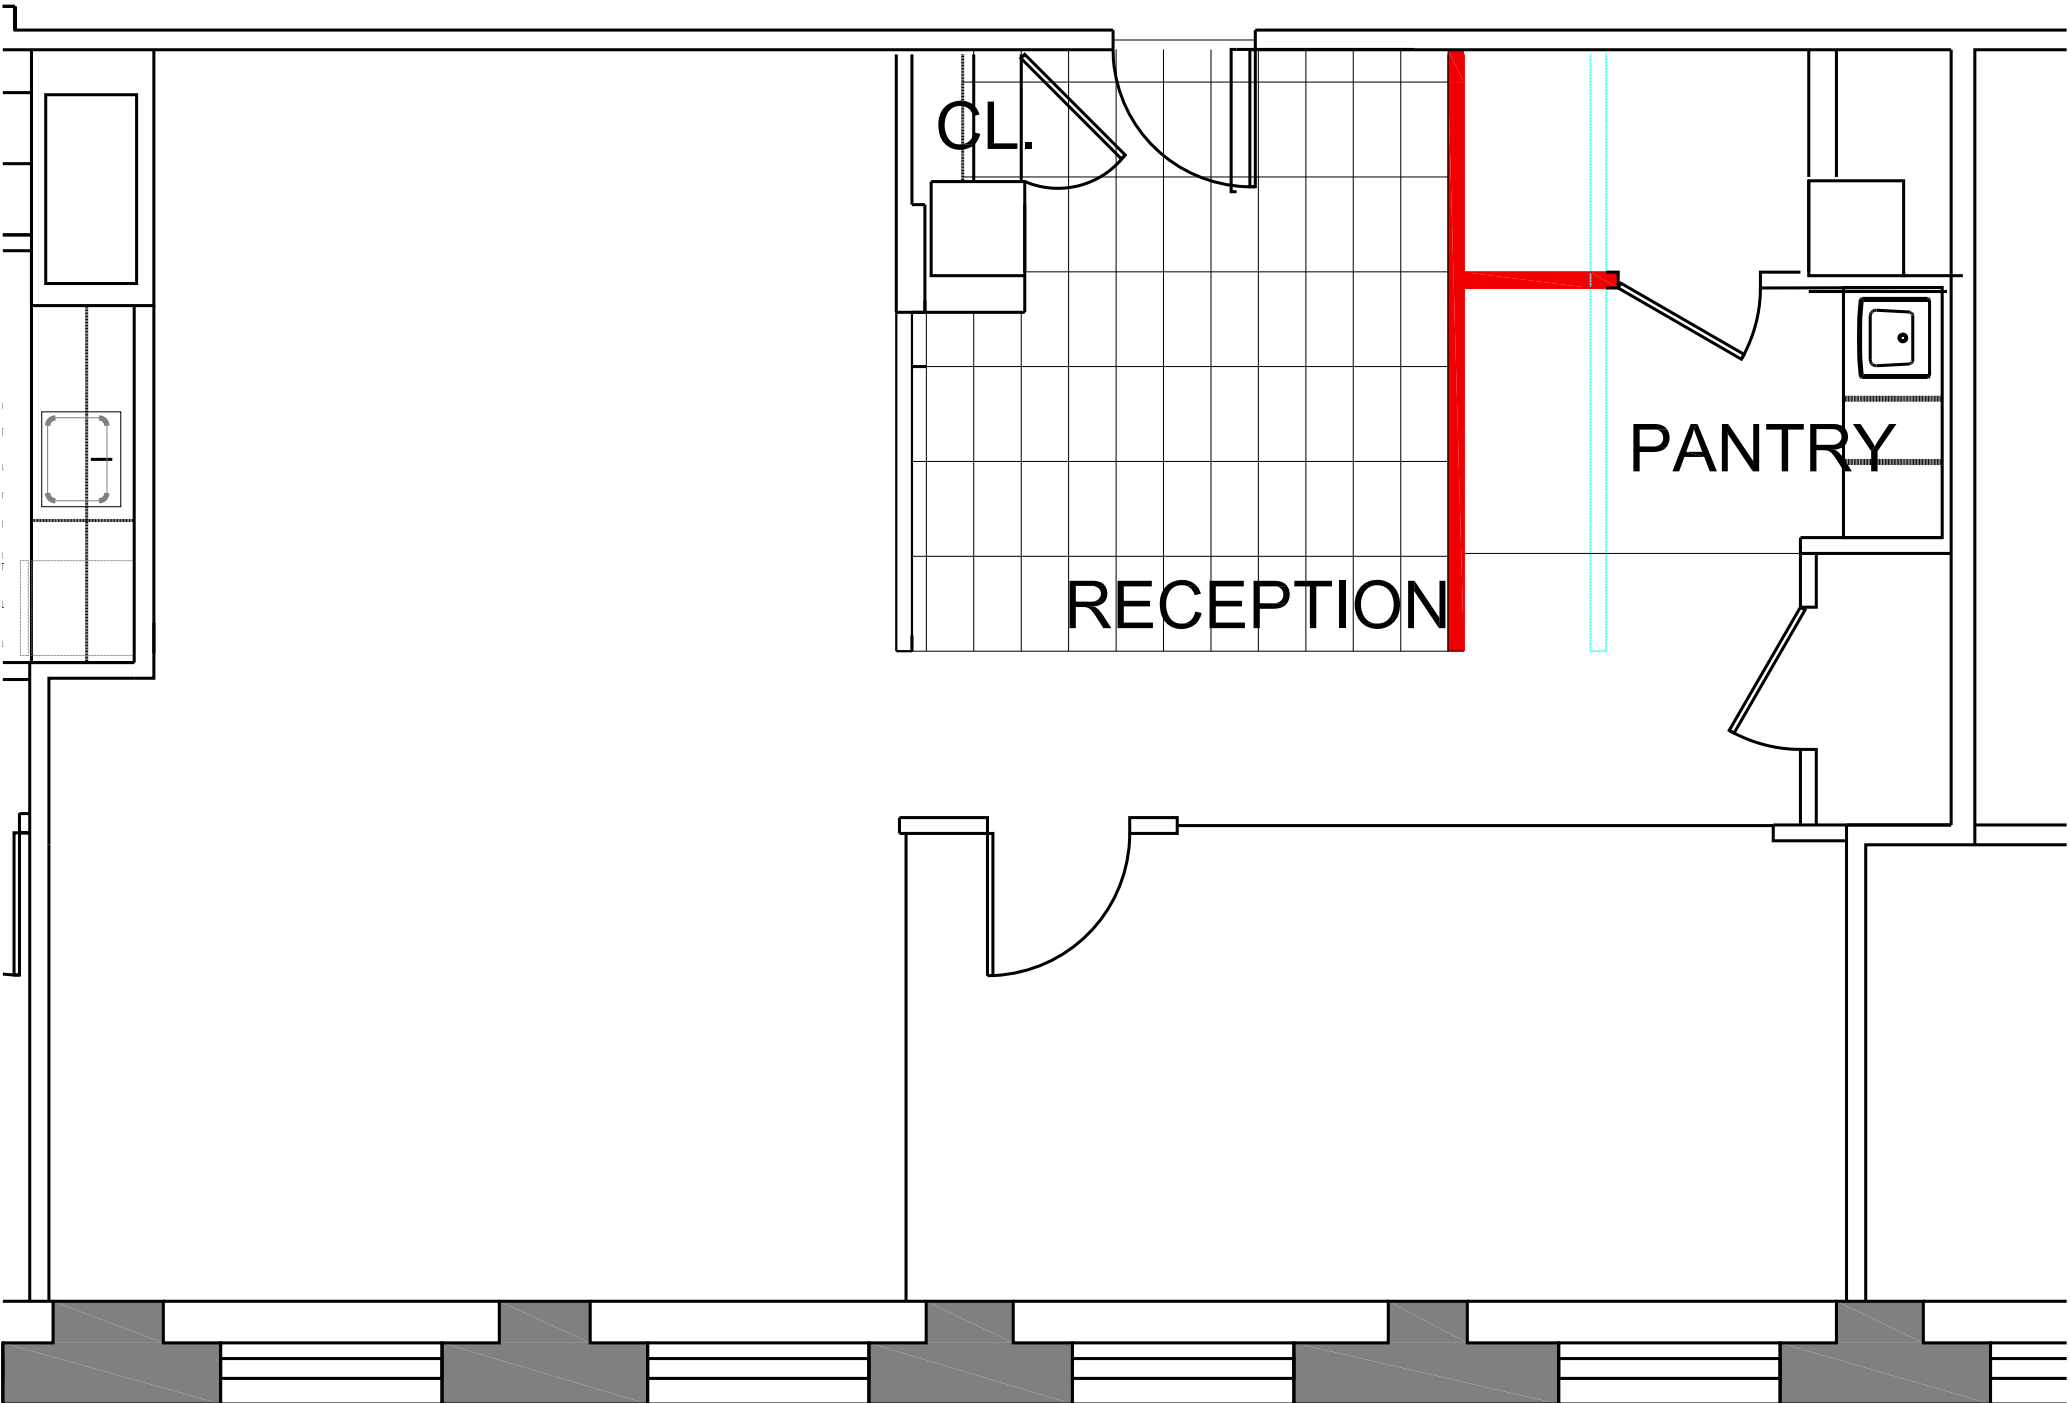

CL.

RECEPTION

PANTRY