
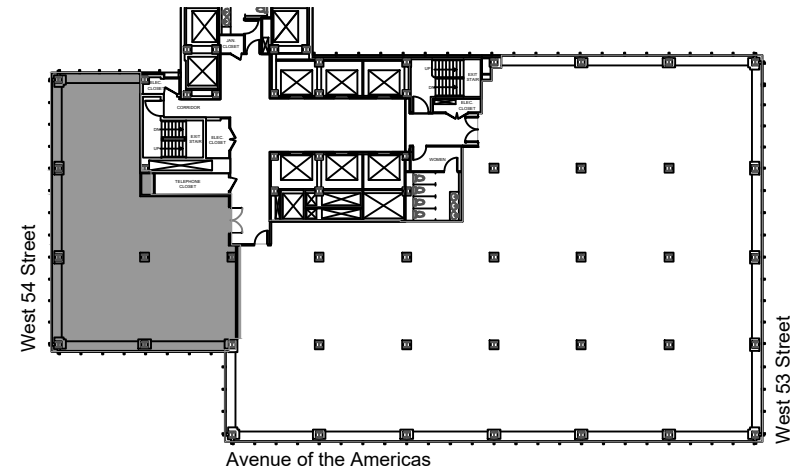


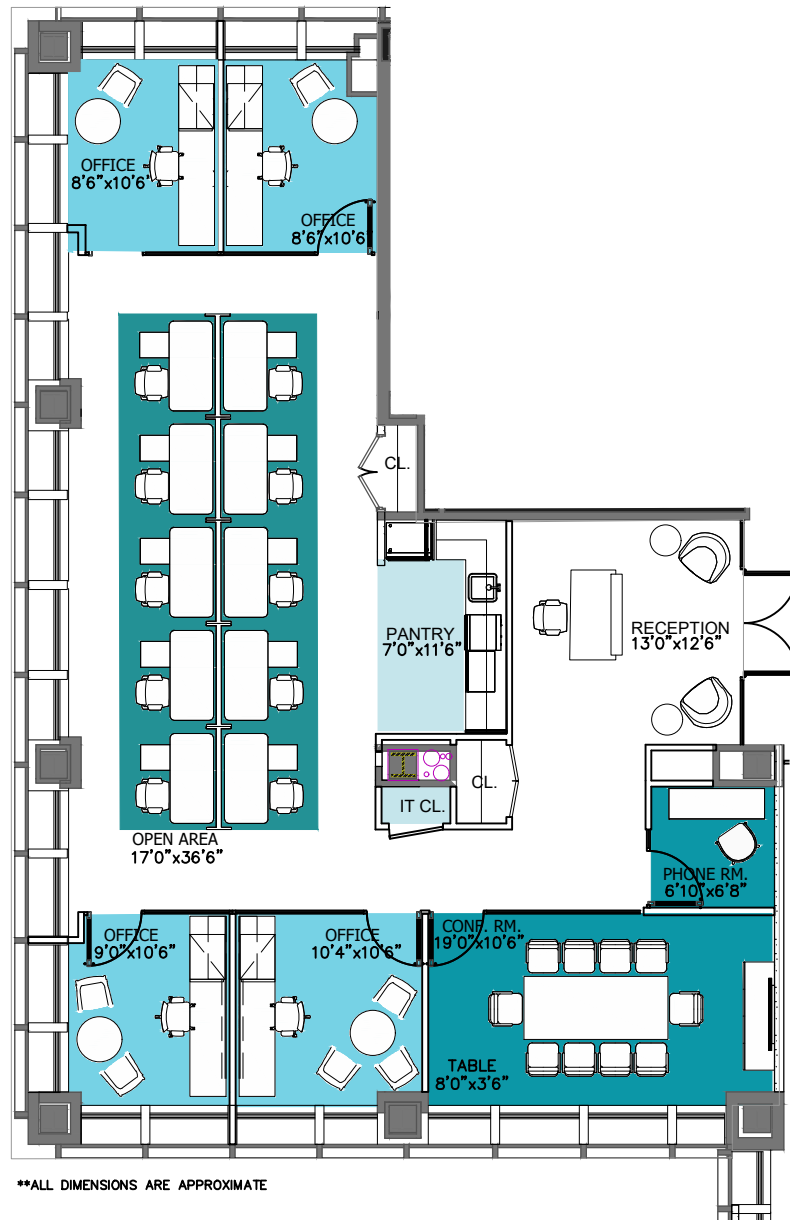

SCALE: $\frac{3}{32}" = 1'-0"$

SUITE 14A- AS BUILT

14th FLOOR
1330 AVENUE OF THE AMERICAS
NEW YORK, NEW YORK 10019